

# KANSAS


Pratt

FORM 51 5M 1-42 PETROL

Section 28 Township 26 Range 12-W

Well No. #1 Briggeman et al

Company Shell

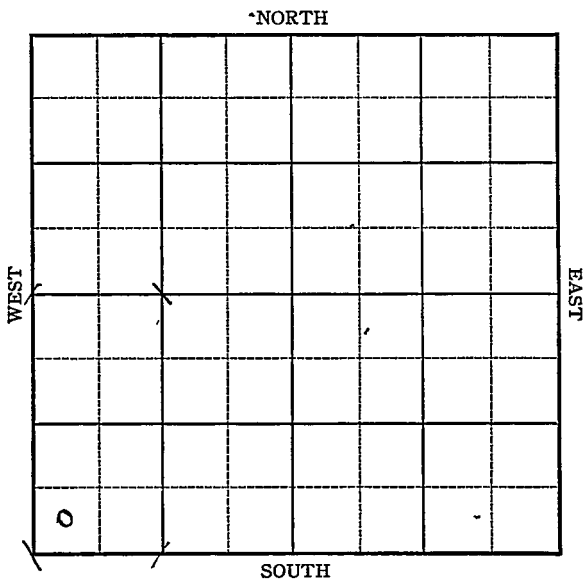

Sec. 28 Twp. 26 R. 12-W

Well No. #1 Briggeman et al. Farm  
Shell Company


\_\_\_\_\_ Ft. from N. Line

330 Ft. from S. Line

\_\_\_\_\_ Ft. from E. Line

330 Ft. from W. Line


El 1913 L+S

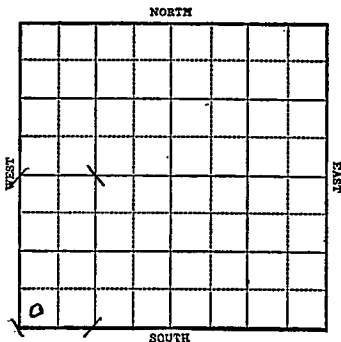

1943

R E P O R T

- 5/5 13" @ 42'  
Drlg. 1525'
- 5/12 8" @ 1771'  
Drlg. 2882'
- 5/19 Lans 3677  
Drlg. 3716'
- 5/26 Drlg. 4020'
- 6/2 Viola 4095  
Drlg. 4206'
- 6/9 Arb. 4272  
4" @ 4275'  
T.D. 4300'  
Flow by heads.
- 6/16 Arb. 4272  
4" @ 4275'  
T.D. 4314'  
2000 gal acid  
Depth Pot 24174  
Max. 3000  
Gravity 40.9

 

**COMPLETED**



