

Pratt

DX 78-1


KANSAS

Section 17 Township 26 Range 12W

Well No. #1 Trimpe

Company Musgrove Pat.

NORTH

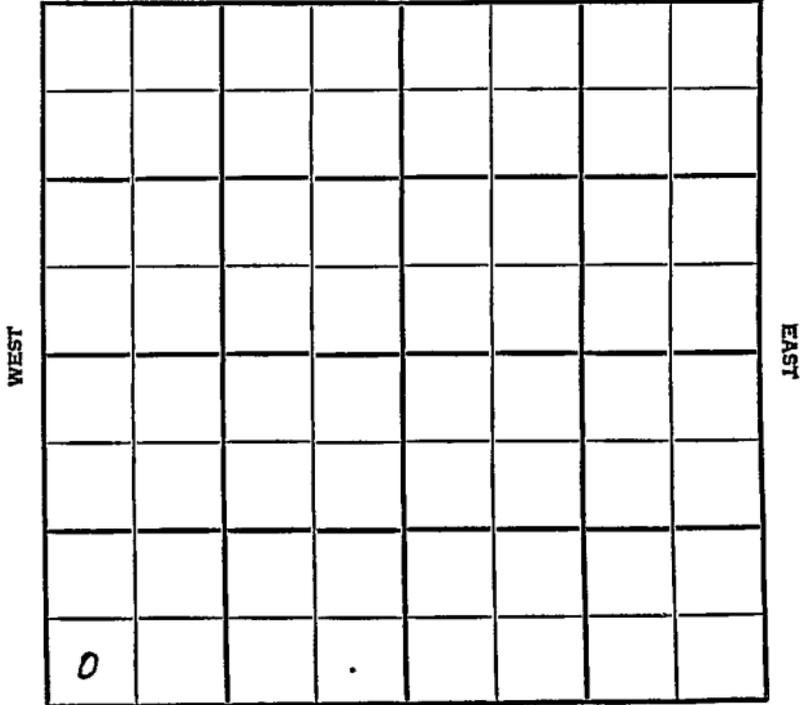

SOUTH

Pratt

KANSAS

SEC.	TWP.	R.
17	26	12W ✓

WELL NO.

COMPANY #1 Trimpe FARM

CONTRACTOR Musgrove Pet.

Musgrove


Wildcat.

Ft. from N. Line

330 Ft. from S. Line

Ft. from E. Line

330 Ft. from W. Line

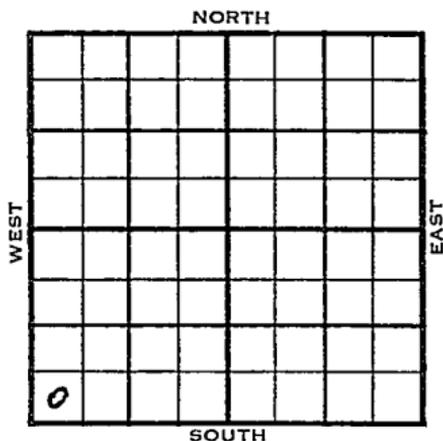

SW SW SW
Texas - DHM

	ELEVATION	REPORT
1954		

5/19	Spud 5-14-54 8" @ 290'	
6/2	Drlg 1645' TD 4444 Spudding 5014-54 D & A 8" @ 290 Top 2182 Heeb 3526 Tör. 3542 Doug. 3562 Br. lime 3697 Lans. 3719 DST 03954-81 open 1hr. Rec. 30' mud 421# BKC 4016 Cong. 4141 Viola 4232 Simp 4310 Arb. 4416. TD 4444 D & A	

ABANDONED

County Pratt State Kansas

Sec. 17 (Bk. 26) (Sur. 12W) Map No.

Operator Musgrove Pet.

Well No. 1 Farm Trimpe

Elev. 1908 Location SW SWSW

ABANDONED

330 Ft. From S Line SW

330 Ft. From W Line Quarter

1st. Report

Completion JUN 2, 1954

Remarks Wildcat

Musgrove - Contr.

Spudding Date 5-14-54

Drlg. Data D & A TD 4444

8" @ 290 Top. 2182 Heeb. 3526

Tor. 3542 Doug. 3562 Br. lime 3697

Lans. 3719 DST 3954-81 open 1 hr.

Rec. 30' mud 421# B KC 4016

Cong. 4141 Viola 4232 Simpl. 4310

Arb. 4416 TD 4444

D & A