


Section 19 Township 26 Range 12W

Well No. #1 Hoener

Company Huber Oil Corp.

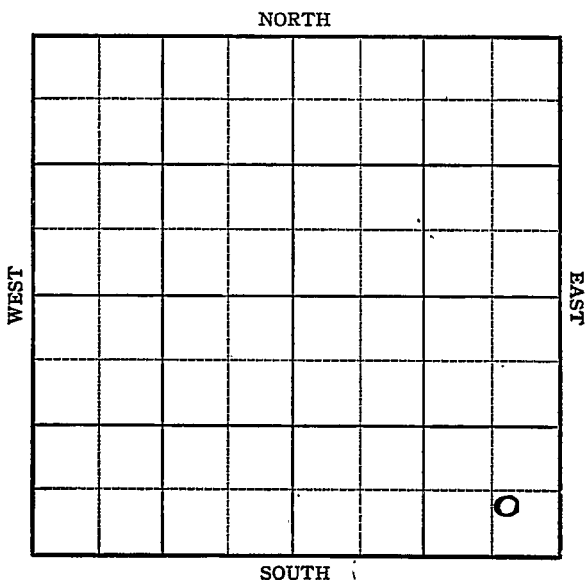

Pratt

Sec. 19 Twp. 26 R. 12W

Well No. #1 Hoener Farm

Huber Oil Corp. Company


Carmi Pool

Ft. from N. Line

590 Ft. from S. Line

590 Ft. from E. Line

Ft. from W. Line

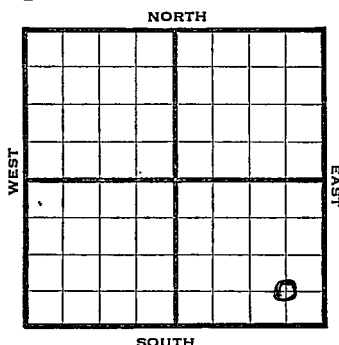

4/10. 1916

1944

REPORT

4/12	Location
4/19	Derrick
4/26	"
5/3	"
5/10	10" @ 45' WOC
5/17	Drlg. 2685
5/24	Topeka 3174
	Lans 3695
	Drlg. 3781
5/31	B KC 3992
	Miss. 4067
	Viola 4110
	Simp. 4188
	Drlg. 4237
6/7	Arb. 4305-10 TD
	5" @ 4307 RUST
6/15	TD 4320 - Swab 30 oil in 22 hrs.
6/21	" " " " "

OVER

1944

6/28 5" @ 4307
Arb. 4305
TD 4320
Pump 35 Pot.
Gravity 40.9

COMPLETED

SAS

Map No. 47 Sec. 19 Twp. 26 R. 12WWell No. 1 HoenerHuber Oil Corp.


Company

FIRST REPORT

Contractor

C SE SE

SECTION PLAT

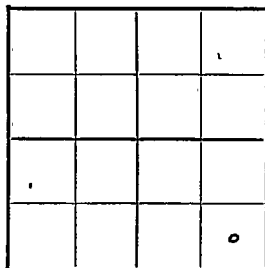

Ft. from N. Line

590

Ft. from S. Line

590

Ft. from E. Line

Ft. from W. Line

Carmi Pool

Location X

Rig up

Drilling and Remarks:

RECORD

Cased _____ in., _____ ft.

Sand _____

Gas _____

Oil _____

Total Depth _____

PRODUCTION

1st 24 hrs. Nat. _____

1st 24 hrs. after shot _____

Gas _____ Cu. Ft.

Dry Hole _____

Abandoned _____

Date

APR 1 2 1944

19

S. J. LEWIS

Scout

Pool Name CarmiMap No. KANSAS 47 Sec. 19 Twp. 26 R. 12WWell No. 1 HoenerHuber Oil Corp. CompanyCOMPLETED Contractor

C SE SE

SECTION PLAT

			6

 Ft. from N. Line590 Ft. from S. Line590 Ft. from E. Line Ft. from W. LinePratt CountyLocation Rig up

Drilling and Remarks:

Ce X 43055" @ 4307Pump 35 P.S.40 F.G.

RECORD

Cased in., ft.Sand Gas Oil Total Depth 4320

PRODUCTION

1st 24 hrs. Nat. 1st 24 hrs. after shot Gas Cu. Ft.Dry Hole Abandoned

Date

JUN 28 1944 19 S. J. LEWIS Scout