
KANSAS Pratt

FORM 51 5M 1-42 PETROL

Section 19 Township 26 Range 12-W

Well No. #1 Thompson

Company Hollow & Appleman

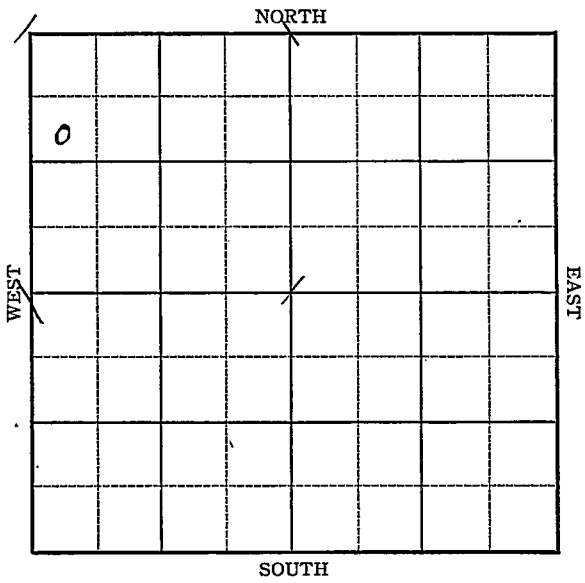

FORM 252-A
5M 9-42 GASS


KANSAS Pratt

Sec. 19 Twp. 26 R. 12-W

Well No. #1 Thompson Farm

Hollow and Appleman Company

(Wildcat

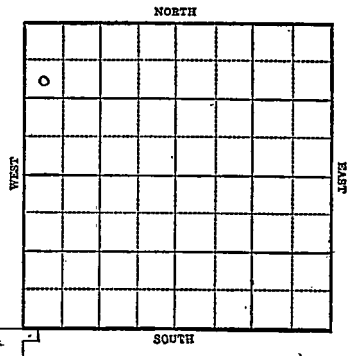

990 Ft. from N. Line

_____ Ft. from S. Line

_____ Ft. from E. Line

330 Ft. from W. Line

SW NW NW

1943	REPORT Elev. 1927
4/27	Drilling 1950' (Telegram)
4/28	8" - 415' Anhy. 780' Topeka 3228 Drlg. 2450' Miss. 4248
5/6	Drlg. 3795 Kind. 4291 Top Lansing 3771 (Tel) Running 68' lower on Lansing than MCPC #1 Knop. (Mannschreck)
5/14	Topped Arbuckle 4459 Viola 4304 T.D. 4509 Simp. 4345 No shows Will plug and abandon (Telegram)
5/19	Arb. 4459 No shows T.D. 4509

ABANDONED

Form 26 200 Bks 5-42 Petrol

Pratt

KANSAS

Map No. 47 Sec. 19 Twp. 26 R. 12W

Well No. 1 Thompson

Hollow & Appleman Company

ABANDONED Contractor

S W NW NW


990 Ft. from N. Line

_____ Ft. from S. Line

_____ Ft. from E. Line

330 Ft. from W. Line

SECTION PLAT

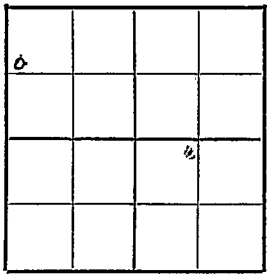

WILDCAT

Location _____

Rig up _____

Drilling and Remarks:

Cer #4459

Noc hard

RECORD

Cased _____ in., _____ ft.

Sand _____

Gas _____

Oil _____

Total Depth 4589

PRODUCTION

1st 24 hrs. Nat. _____

1st 24 hrs. after shot _____

Gas _____ Cu. Ft.

Dry Hole _____

Abandoned _____

Date

MAY 19 1943

19

S. J. LEWIS Scout

Form 26 200 Bks. 5-42 Petrol

KANSAS Pratt

Map No. 47 Sec. 19 Twp. 26 R. 12W

Well No. 1 Thompson

Hollow & Appleman Company

FIRST REPORT Contractor

SW NW NW


990 Ft. from N. Line

_____ Ft. from S. Line

_____ Ft. from E. Line

330 Ft. from W. Line

SECTION PLAT

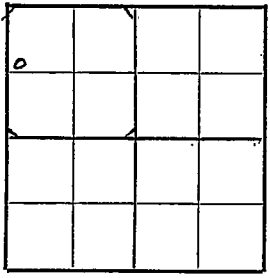

WILDCAT

Location

Rig up

Drilling and Remarks:

8"-415'

Anhy. 780'

Drlg. 2450'

RECORD

Cased ____ in., ____ ft.

Sand

Gas

Oil

Total Depth

PRODUCTION

1st 24 hrs. Nat.

1st 24 hrs. after shot

Gas ____ Cu. Ft.

Dry Hole

Abandoned

Date

APR 2 8 1943 19

S. J. LEWIS Scout