


Section 20 Township 26 Range 12W

Well No. #1 Hoeme

Company Transit Corp. & N C R A

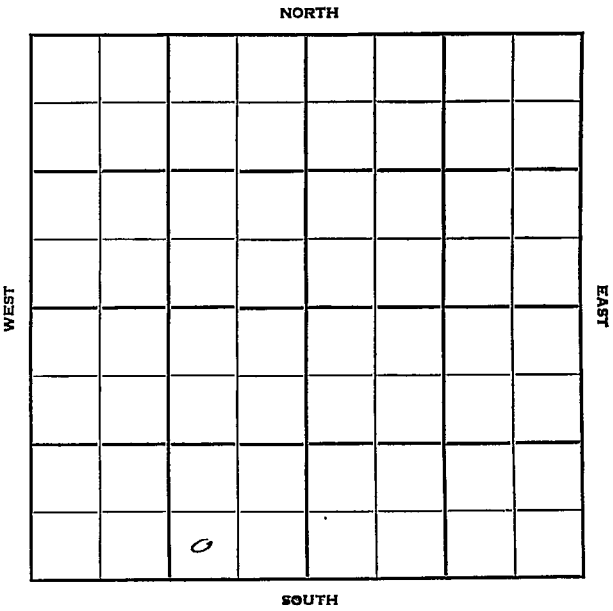

Sec. 20 Twp. 26 R. 12W

Well No. #4 Hoeme Farm

Transit Corp. & NCRA Company

Transit Contractor


Ft. from N. Line

330 Ft. from S. Line

990 Ft. from E. Line

Ft. from W. Line

SW SE SW

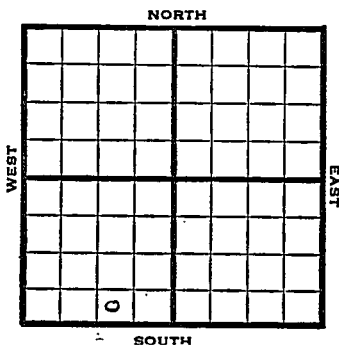

1952

Elev. 1915' REPORT

4/2

Spud 3-28-52  
8" @ 805' Anhy 795'  
Drlg. 2215

4/9

Topeka 3190 Heeb. 3487 Dodge 3508  
Br Li 3659 Lans. 3684  
Drlg. 3820'

4/23

DST 3826-44 1 hr. 140 OCM 210' oil  
450 SW 1405 #  
DST 3850-74 2 hrs. 150' HGCM 150'  
GCM muddy wtr 170#  
DST 3880-91 2 hrs. 90' GCM 330#  
DST 3996-28 1 hr. 60' GCM 120' M  
945# V 4069' Simp 4178  
Arb. 4293  
DST 4293-4303 RTD 2 hrs. 120' oil  
60' HOCM 1365# Schl 5" @ 4295

4/30

NR

5/7

DP DD 4304 TD S/23 BO 8 hrs.

5/14

500 A est. 15 Boph POP

5/21

NR

5/28

"

6/11

Spud 3-28-52  
Oil Well TD 4304' 8" @ 805'  
Anhy 795 Top. 3190  
Heeb. 3487 Dodge 3508  
Br Li 3659 Lans. 3684

OVER

1952

6/11 DST 3826-44 open 1 hr. rec. 140' ocm  
210' oil 450' sw  
DST 3850-74 open 2 hr. rec. 150'  
hgcm socm 150' gcmw  
DST 3880-91 open 2 hr. rec. 90' gcm  
DST 3916-28 open 1 hr. rec. 60' gcm  
120' mud Viola 4069 Simp. 4178  
Arb. 4293  
DST 4293-4303 TD open 2 hr. rec.  
120' oil 60' hocm 5" @ 4295'  
TD 4304 S/ 23 bo 8 hr. 500 A  
150 boph Comp. 242 bopd

**COMPLETED**



