


Section 20 Township 26 Range 12W

Well No. #6 Hoeme

Company Transit Corp.

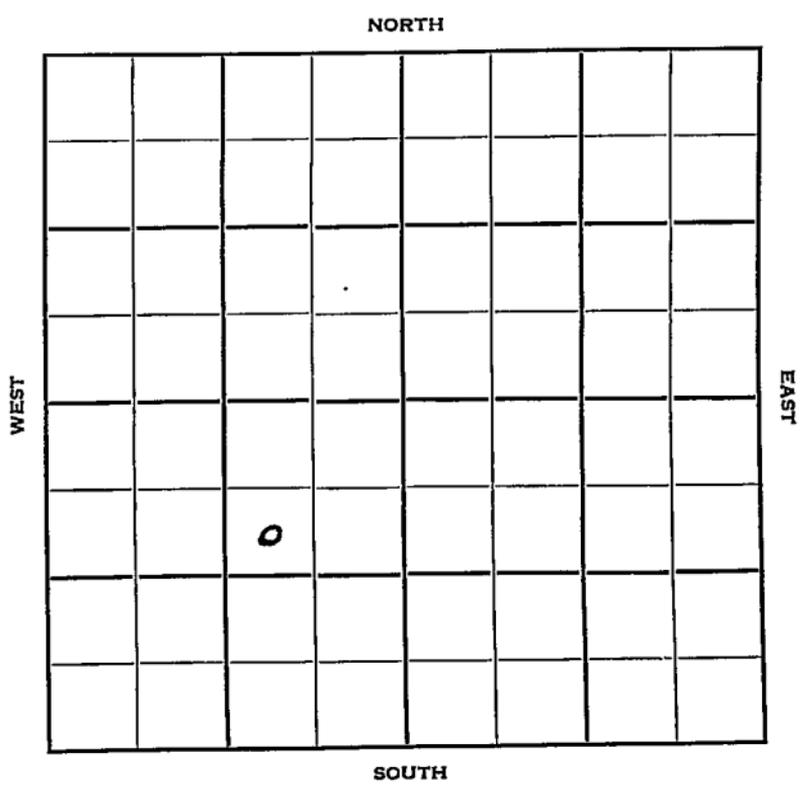

Sec. 20 Twp. 26 R. 12W

Well No. #6 Hoeme Farm

Transit Corp. Company

Transit Corp. Contractor

Tuka-Carmi Pool


990 Ft. from N. Line

_____ Ft. from S. Line

990 Ft. from E. Line

_____ Ft. from W. Line

SW NE SW

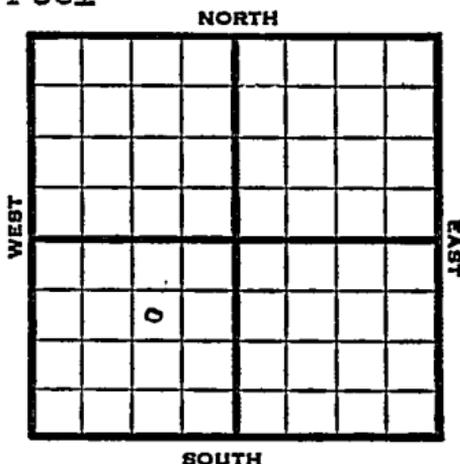

1952

Elev. 1906' REPORT

10/15

Spud 10-12-52
8" @ 256' WOC

10/22

Heeb 3502' Tor. 3515' Br. li 3674'
Lans. 3698'
Drilling

10/29

KC 4011, Miss 4061, V 4085, Simp sha
4217
DST 4178-4223, 2½ hrs., 20' M
Simp Dol 4233, Simp sd 4239
Drlg. 4327'

11/5

Arb 4331
DST 4331-40, 2 hrs., 12' M
40# RTD 4448
5" @ 4356'

11/12

NR

11/19

Spud 10-12-52
SWD Well
TD 4500
8" @ 256
Heeb 3502, Tor 3515, Br. lime
3674, Lans 3698, KC 4011,
Miss 4061, Viola 4085, Simp
4217
DST 4178-4200, opn 2½ hrs.,
rec. 20' mud, 40#

OVER

(Information Brought Forward)

1952

11/19

Simp. dol. 4233, Simp. sd 4239

Arb. 4331

DST 4331-40, opn 2 hrs., rec.

12' mud, 40#

TD 4500

5" @ 4356

Comp. for SWD Well

ABANDONED

