


Section 20 Township 26 Range 12-W

Well No. 1 H. Hoeme

Company Helmerich & Payne et al

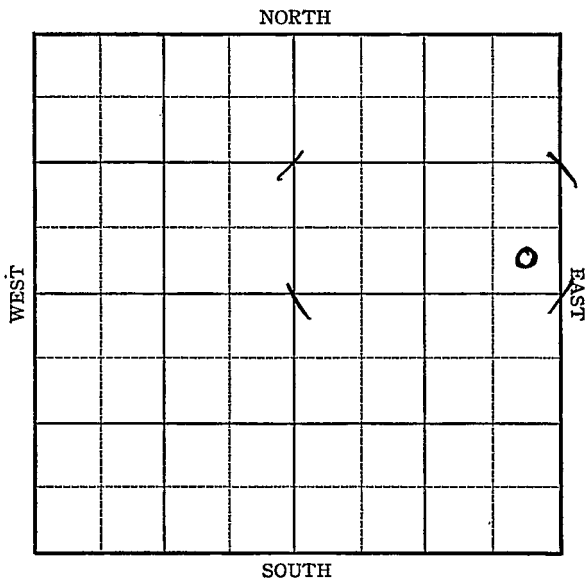

Sec. 20 Twp. 26 R. 12-W

Well No. #1 H. Hoeme Farm

Helmerich & Payne et al Company


 Ft. from N. Line

330 Ft. from S. Line

330 Ft. from E. Line

 Ft. from W. Line

Elev. 1911

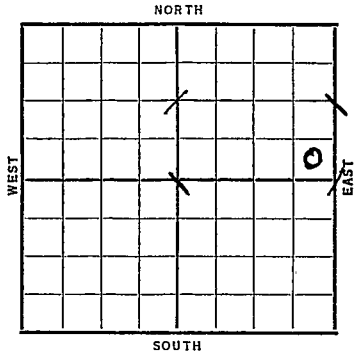

Date	REPORT
1937	
11/23	Location
12/3	B. R. R.
12/10	T.D. 735'. Reaming.
12/17	10" @ 442'. Anhy 730'. Drlg. 2722'.
12/24	K.C. 3720'. S.O. 3808'. Drlg. 4110'.
12/31	Cherty Cong. 4085'.
	Viola 4135'. Drlg. 4200'.
	No shows.
1938	
1/5	Simp. 4344'.
	Arb. 4427'.
	T.D. 4470'.
	No shows.
	COMPLETED

Map No. 47 Sec. 20 Twp. 26 R. 12WWell No. 1 H. HoemeHelmerich & Payne etal Company

Contractor

Stano. Farm. out

FIRST REPORT

SE NE

SECTION PLAT

_____ Ft. from N. Line

330 Ft. from S. Line330 Ft. from E. Line

_____ Ft. from W. Line

Location X

Rig up _____

Drilling and Remarks:

RECORD

Cased _____ in., _____ ft.

Sand _____

Gas _____

Oil _____

Total Depth _____

PRODUCTION

1st 24 hrs. Nat. _____

1st 24 hrs. after shot _____

Gas _____ Cu. Ft.

Dry Hole _____

Abandoned _____

Date

NOV 23 1937 19H. D. Hatfield Scout

Pratt

KANSAS

Map No. 47 Sec. 20 Twp. 26 R. 12W

Well No. 1 H. Home

Helmerich & Payne et al Company

Contractor

ABANDONED

SE NE

_____ Ft. from N. Line

330 Ft. from S. Line

330 Ft. from E. Line

_____ Ft. from W. Line

SECTION PLAT

			0

Location _____

Rig up _____

Drilling and Remarks:

No shows

DVA

RECORD

Cased Simp in., 4344 ft.

Sand Arb 4427

Gas _____

Oil _____

Total Depth 4470

PRODUCTION

1st 24 hrs. Nat. _____

1st 24 hrs. after shot _____

Gas _____ Cu. Ft.

Dry Hole _____

Abandoned _____

Date

JAN 5 - 1938

H. D. Hatfield Scout