


Section 13 Township 26 Range 12W

Well No. #1 Schwertfeger

Company Bay Petroleum

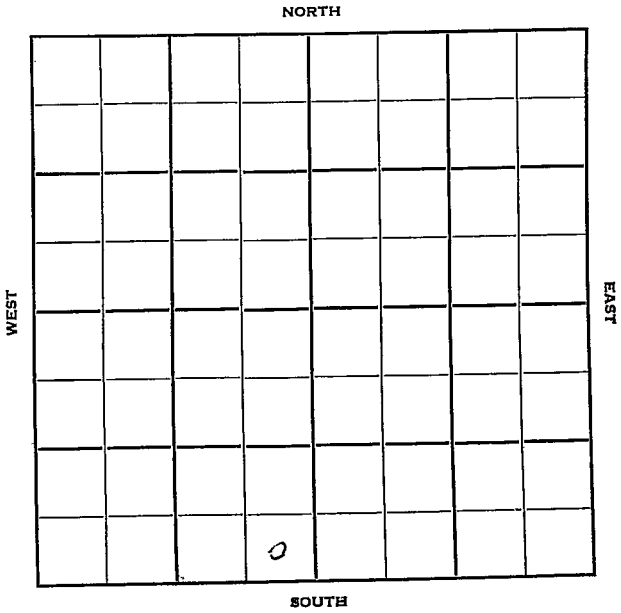

Sec. 13 Twp. 26 R. 12W

Well No. #1 Schwertfeger Farm

Bay Petroleum Company

Pickrell Drlg. Contr. Contractor

Semi-Wildcat


\_\_\_\_\_ Ft. from N. Line

330' Ft. from S. Line

330' Ft. from E. Line

\_\_\_\_\_ Ft. from W. Line

SE SE SW

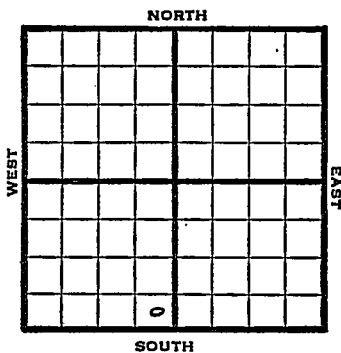

1950 Elev 1867 REPORT

10/4 Spud 9-30-50  
8-5/8" @ 360'  
Drlg. 2325'

10/18 8 5/8" @ 360  
Viola 4133  
DST 3871-88 opn 45 min rec 60' o&gcm  
DST 4135-47 op 45 min rec 15' sgcm  
Simp 4238 Arg 4322  
TD 4348  
D&A

**ABANDONED**



