KANSAS

FORM [illegible] PETROL


Pratt

O.W.W.O.

Section 28 Township 26 Range 12W

Well No. #1 ~~S. Smith~~ HALL

Company Stanolind

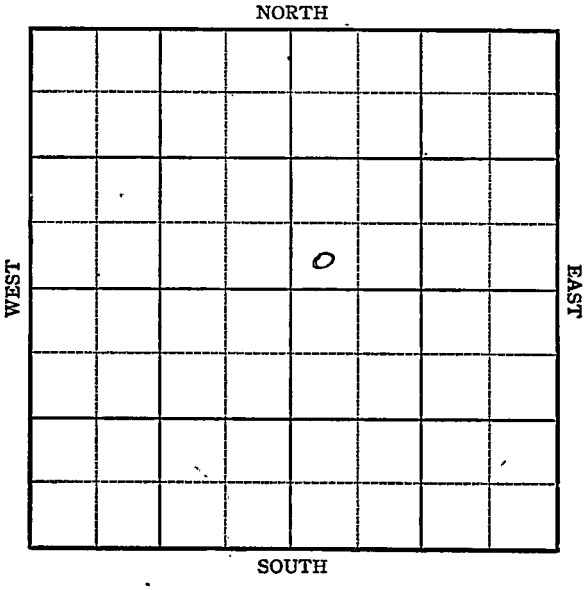

FORM 252-A
5M 9-43 GAS

KANSAS

O.W.W.O.


Pratt KANSAS

Sec. 28 Twp. 26 R. 12W

Well No. #1 ~~G. Smith~~ HALL Farm

Stanolind Company

Carmi

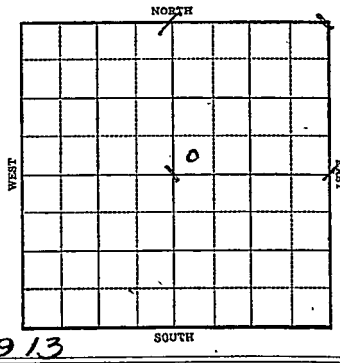

____ Ft. from N. Line

330 Ft. from S. Line

____ Ft. from E. Line

330 Ft. from W. Line

SW NE Elev. 1913

1944	REPORT
2/9	Derrick
2/15	"
2/23	Rotary
3/1	8" @ 904' Drlg. 2315
3/8	Lans 3695 Drlg. 3860
3/16	Viola 4147 Arb. 4290 TD 4318 5" @ 4294 Rust
3/22	"
3/29	"
4/5	TD 4318 Swb 43 oil per hr 3 hrs.
4/12	500 acid flow 41½ oil per hr 3 hrs.
~~4/19~~	" " "
4/26	" " "

OVER

1944

5/3 500 acid flow 41½ oil per hr.

5/10 " "

5/17 Arbuckle 4290
5" - 4294
500 acid
Bomb Pot. 6260
Max. 3000
Gravity 40.2
Total Depth 4318

COMPLETED

1952 O.W.W.O.

4/1 V 4147 Simp. 4195
5" @ 4294' OTD 4318' was Arb. Prod.
PB 4270 32/ 4204-12 S/ 16 boph
for 10 hrs. Grav. 39.4 F/ 17
BOPH for 10 hrs. SSG Hyd.
329 bopd Comp.

FIRST REPORT
&
COMPLETED

FORM 275 FOR SALE BY KANSAS BLUE PRINT CO.


County Pratt State Kansas

Sec. 28 (Blk. Twp.) 26 (Sur. Rge.) 12W Map No.

Operator Stanolind

Well No. 1 Farm G. Hall

Elev. 1913 Location SW SW NE

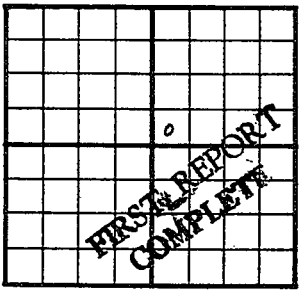

330 Ft. From S Line NE

330 Ft. From W Line Quarter

1st. Report APR 2 1952

Completion APR 2 1952

Remarks OWWO

O.W.W.O.

Spudding Date

Drlg. Data

V 4147 Simp 4195 Arb. 4290 5" @ 4294

OTD 4318 was arb prod. PB 4270 32/4204-12 S/16 Boph for 10 hrs. G 39.4 F/17 Boph for 10 hrs. SSG Hyd. 329 Bopd Comp.

J. G. McGEHEE

Form 26 200 Bks 5-42 Petrol

Pratt

KANSAS

Map No. 47 Sec. 28 Twp. 26 R. 12W

Well No. 1 G. Smith


Stanolind Company

FIRST REPORT

Contractor

SW NE

SECTION PLAT

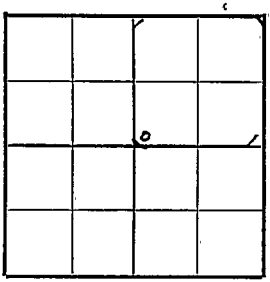

____ Ft. from N. Line

330 Ft. from S. Line

____ Ft. from E. Line

330 Ft. from W. Line

Carmi Pool

Location

Rig up

Drilling and Remarks:

Derrick

RECORD

Cased ____ in., ____ ft.

Sand

Gas

Oil

Total Depth

PRODUCTION

1st 24 hrs. Nat.

1st 24 hrs. after shot

Gas ____ Cu. Ft.

Dry Hole

Abandoned

Date

FEB 9 1944 19

S. J. LEWIS Scout

Form 26 200 Bks 5-42 Petrol Pratt

Map No. ~~KANSAS~~ Sec. 28 Twp. 26 R. 12W


Well No. 1 Hall

Stanolind Company

CORRECTION Contractor

SW NE

SECTION PLAT

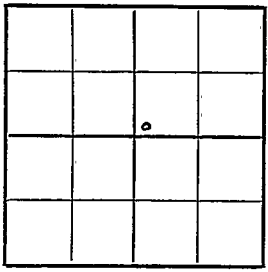

____ Ft. from N. Line

330 Ft. from S. Line

____ Ft. from E. Line

330 Ft. from W. Line

Carmi Pool

Location

Rig up

Drilling and Remarks:

Reported
#1 Smith

RECORD

Cased ____ in., ____ ft.

Sand

Gas

Oil

Total Depth

PRODUCTION

1st 24 hrs. Nat.

1st 24 hrs. after shot

Gas ____ Cu. Ft.

Dry Hole

Abandoned

Date

FEB 2 3 1944 19

S. J. LEWIS Scout

FORM 26 200 BKS 2-44 PETROL

KANSAS

Pool Name Carmi

Map No. 47 Sec. 28 Twp. 26 R. 12W


Well No. 1 Hall

Stanolind Company

COMPLETED Contractor

SW NE

SECTION PLAT

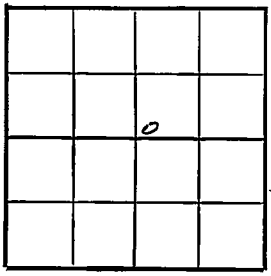

____ Ft. from N. Line

330 Ft. from S. Line

____ Ft. from E. Line

330 Ft. from W. Line

Pratt County

Location

Rig up

Drilling and Remarks:

Cr Y 4290
S C 4294
500 acid
Bom Y 8Y 6260
Mag 3000

40 2/3

RECORD

Cased ____ in., ____ ft.

Sand

Gas

Oil

Total Depth 4315

PRODUCTION

1st 24 hrs. Nat.

1st 24 hrs. after shot

Gas ____ Cu. Ft.

Dry Hole

Abandoned

Date

MAY 17 1944 19 S. J. LEWIS Scout