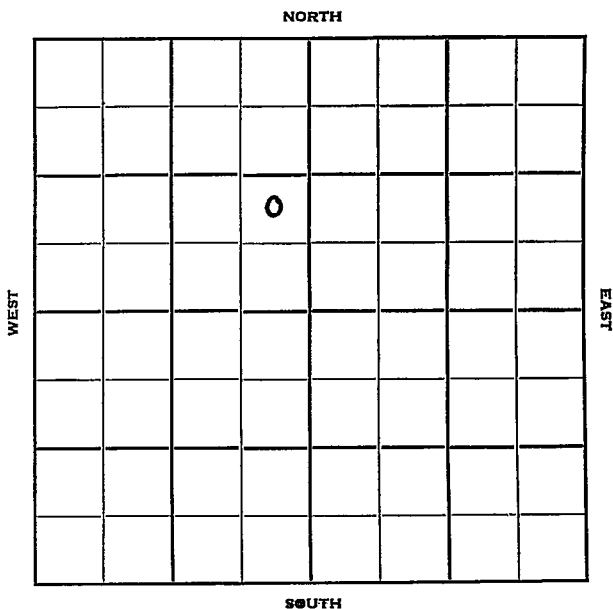


Section 28 Township 26 Range 12 WWell No. # 5 O. H. HoemeCompany Shell Oil

Sec. 28 Twp. 26 R. 12W

Well No. #5 O. H. Hoeme Farm

Shell Oil Company

Contractor


Ft. from N. Line

1044' Ft. from S. Line


330' Ft. from E. Line

Ft. from W. Line

NE SE NW

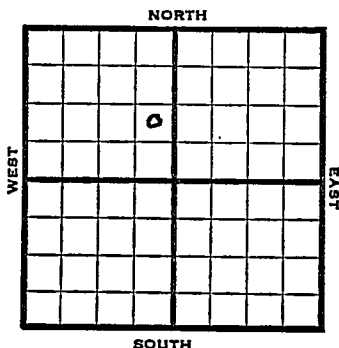

| 1952      | Elev. 1914'   | REPORT |
|-----------|---|--------|
| 6/25      | Spud 6-19-52<br>8" @ 736<br>Drlg. 2275'   |        |
| 7/2       | Topeka 3148' Tor. 3496'<br>Lans. 3676'<br>Drlg. 3817'   |        |
| 7/9       | V 4119'<br>DST 4119-39, 1 hr, 38' M 225#<br>Simp 4178' Arb. 4281' RTD 4283'<br>Schl   |        |
| 7/17      | 4" @ 4284 CO 4284 72/4194-4212<br>Hyd   |        |
| 7/23      | F 58 BO & 1 BW 4 hrs.<br>F 80 BO & 7 hrs. 2" tub.   |        |
| 7/30      | Spud 6-19-52<br>Oil Well TD 4285 8" @ 736<br>Top. 3148 Tor. 3496<br>Lans. 3671 Viola 4119<br>DST 4119-39 open 1hr. rec. 38' mud<br>225# Simp. 4178 Arb. 4281<br>TD 4285 4" @ 4284 CO to 4284<br>72/ 4194-4212 Hydro. F/ 58 bo<br>1 bw 4 hr. F/ 80 bo 7 hr.<br>Comp. F/ 184 bopd |        |
| COMPLETED |   |        |

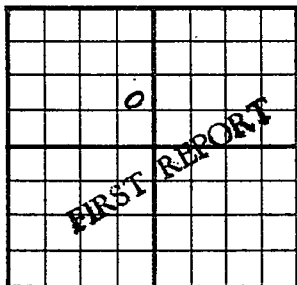County Pratt State KansasSec. 28 (Blk.) 26 (Sur.) 12W Map No.Operator Shell OilWell No. 5 Farm O. H. HoemaElev. Location NE SE NW1044 Ft. From S Line NW330 Ft. From E Line QuarterIst. Report JUN 25 1952

Completion


Remarks

Spudding Date 6-19-52

Drlg. Data

8" @ 736 Drlg. 2275J. G. McGEHEE

County Pratt State Kansas  
 Sec. 28 (Blk. 26 (Sur. 12W Map No.  
 (Twp.) (Rge.)  
 Operator Shell Oil  
 Well No. 5 Farm O. H. Hoeme  
 Elev. 1914 Location NE SE NW

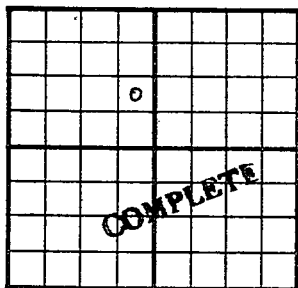

1044 Ft. From S Line NW  
330 Ft. From E Line Quarter

1st. Report

Completion JUL 30 1952

Remarks

Spudding Date 6-19-52

Drlg. Data Oil well TD 4285

8" @ 736 Top. 3148 Tor. 3496

Lans. 3671 Viola 4119 DST 4119-39

open 1 hr. Rec. 38' mud 225#

Simp. 4178 Arb. 4281 TD 4285

4" @ 4284 CO to 4284 72/ 4194-4212

Hydro. F/ 58 bo 1 bw 4 hr.

F/ 80 bo 7 hr. Comp. F/ 184 bopd