


Section 29 Township 26 Range 12W

Well No. #1 Brown "B"

Company Hollow Drilling CRA

Wildcat

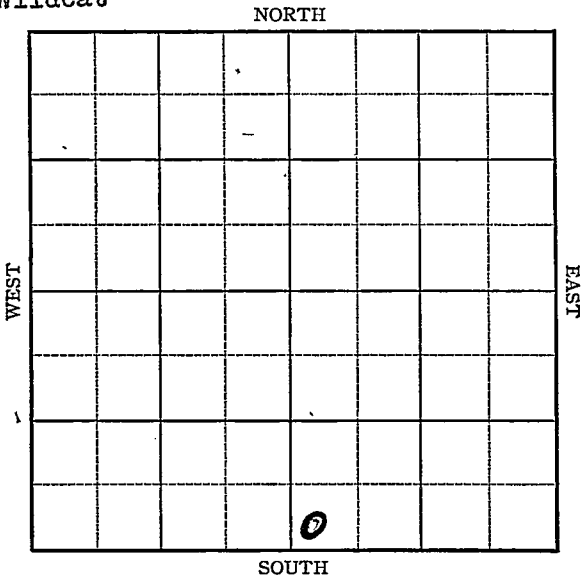

Sec. 29 Twp. 26 R. 12W


Well No. 1 Brown "B" Farm
~~Hollow Drilling~~ CRA Company

_____ Ft. from N. Line

330 Ft. from S. Line

_____ Ft. from E. Line

330 Ft. from W. Line

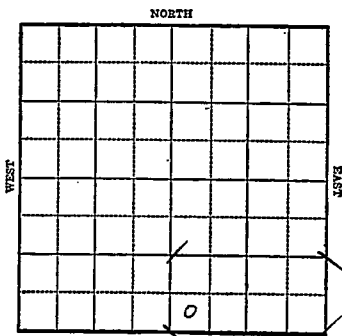

Elev. 1912 SWSWSE

1942

R E P O R T

10/28 8" - 467
WOC

11/4 Drlg. 2000

11/11 Lans 3672 SO 3775-90, 3830-40,
3875-88
Drlg. 4048'

11/18 Miss 4110
Simp 4188
Arp 4268-81
TD
7" @ 4268 rust

11/24 TD 4280
140' oil in 2 hrs.

12/2 2000 acid 3500' oil 33 hrs.

12/9 TD 4289-2680 oil in 14 hrs.

12/16 TD 4297 $\frac{1}{2}$ swb
145 oil in 8 hrs 2300' off
bottom Gr. 404

12/22 SD for tank room.

12/29 " " "

OVER

1943
 1/6 SD for tank room.
 1/13 Swab 84 Oil 5 hrs 3200' off
 bottom.
 1/20 250 acid swb & flow 74 bbls
 oil 5 hrs 1500' off bottom.
 1/27 Arb. 4268
 7" @ 4268' . 3R
 T.D. 4297½'
 2250 gals acid
 Echo Pot 6391
 Max. 3000
 Gravity 36.8

COMPLETED

1956 **O. W. P. E**
 3/14 OTD 4282' 7" @ 4268 CO to test KC
 Tops: KC 3672', V 4110' S 4163'
 A. 4268'
 4-25 CO 4136, 60/ 4110-25,
 B/ 1 gf, 1000 A
 SP 4102,
 PB 4095, 24/ 3911-17, 28/ 3925-32
 1 gwph, 6000 A,
 S/ 51 bo, 36 bw, 18 hrs.,
 PB 3882, 20/ 3825-30, 12 goph,
 2½ gwph, 5 hrs., 1500 A
 S/ 49 bo, 1 bw, 21 hrs.
 P/ ~~60~~ 6 bo, 24 hrs., 25% wtr., 3000 A
 Comp. 6.75 bopd, 5.25 bw
 TD 4282'

COMPLETED

Map No. 47 Sec. 29 Twp. 26 R. 12WWell No. 1 Brown "B"

Hollow Drilling _____ Company

FIRST REPORT _____ Contractor

SW SE

SECTION PLAT


_____ Ft. from N. Line

330 Ft. from S. Line

_____ Ft. from E. Line

330 Ft. from W. Line

WILDCAT

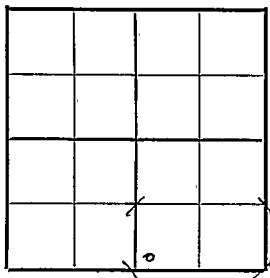

Location _____

Rig up _____

Drilling and Remarks:

8" - 467WOC

RECORD

Cased _____ in., _____ ft.

Sand _____

Gas _____

Oil _____

Total Depth _____

PRODUCTION

1st 24 hrs. Nat. _____

1st 24 hrs. after shot _____

Gas _____ Cu. Ft.

Dry Hole _____

Abandoned _____

Date

OCT 28 1942 19S. J. LEWIS Scout

Pratt

KANSAS

Map No. 47 Sec. 29 Twp. 26 R. 12W

Well No. 1 Brown "B"

Hollow Drilling Company

COMPLETED Contractor

SW SE

SECTION PLAT

_____ Ft. from N. Line

330 Ft. from S. Line

_____ Ft. from E. Line

330 Ft. from W. Line

		o	

GARMI POOL

Location _____

Rig up _____

Drilling and Remarks:

CR 4268
7" @ 4268
2250 acid
Ech Pad 6391
May 3000
365 Gr

RECORD

Cased _____ in., _____ ft.

Sand _____

Gas _____

Oil _____

Total Depth 4297 1/2

PRODUCTION

1st 24 hrs. Nat. _____

1st 24 hrs. after shot _____

Gas _____ Cu. Ft.

Dry Hole _____

Abandoned _____

Date

JAN 27 1943 19

S. J. LEWIS Scout

~~O. W. P. B.~~
~~OWPB~~

County Phatt Elev. 1912
 Sec. 29 Twp. 26 Rge. 12W
 Company C R A
 FarmName Brown #B No. 1

TOPS	DEPTH	LOG	DATUM
Anh.			
Tp.			
H.			
Tr.			
Dg.			
BL.			
L.			
K.C.	3672		
B.K.C.			
Ce.			
C.			
M.			
M.			
K.			
Mz.			
Me.			
V.	1110		
S.	1163		
S.	1268		
A			
R.			
PE.			
G.			
TD.			

Loc. in Sec. SW SW SE

Geol. _____
 Contr. _____

Pool Iuka-Carni

FIRST REPORT
 MAR 24 1956

MAR 14 1956

Date Comm. OTD 4282 7" @ 4268 CO to test KC

Co.
Lse.
No.
Sec.
T.
R.

OWPB

County Pratt Elev. 1912
 Sec. 29 Tr. 26 Rge. 12W
 Company C R A
 Farm Name Brown "B" No. 1

TOPS	DEPTH	LOG	DATUM	Loc. in Sec.																					
Anh.				SW SW SE																					
Tr.																									
H.																									
Tr.																									
Dg.																									
Bl.																									
L.																									
K.C.	<u>3672</u>		<u>1760</u>	Geol.																					
B.K.C.				Contr.																					
Ce.																									
C.																									
M.																									
M.				Pool																					
K.				<u>Iuka-Garmi</u>																					
Mz.																									
Me.																									
V.	<u>4110</u>		<u>2198</u>	<table border="1"> <tr><td></td><td></td><td></td></tr> <tr><td></td><td></td><td></td></tr> <tr><td></td><td></td><td></td></tr> <tr><td></td><td></td><td></td></tr> <tr><td></td><td></td><td></td></tr> <tr><td></td><td></td><td></td></tr> <tr><td></td><td></td><td></td></tr> </table>																					
S.																									
S.	<u>4163</u>		<u>2251</u>																						
A.	<u>4268</u>		<u>2356</u>																						
R.																									
PE.																									
G.																									
TD.	<u>4282</u>																								

Date Comm. APR 25 1956

OTD 4282. 7" @ 4268 CO 4136
 60/ 4110-25 B/ 1 gf 1000 A SP 4102
 PB 4095 24/ 3911-17 28/ 3925-32
 1 gwph 6000 A S/ 51 bo 36 bw 18 hr.
 PB 3882 20/ 3825-30 12 goph
 2 1/2 gwph 5 hr. 1500 A S/ 49 bo
 1 bw 21 hr. P/ 6 bo 24 hr. 25% wtr.
 3000 A Comp. 6.75 bopd 5.25 bw