

# KANSAS


FORM 51 5M 1-42 PETROL

Pratt

Section 29 Township 26 Range 12-W

Well No. #2 Hoene

Company Skelly

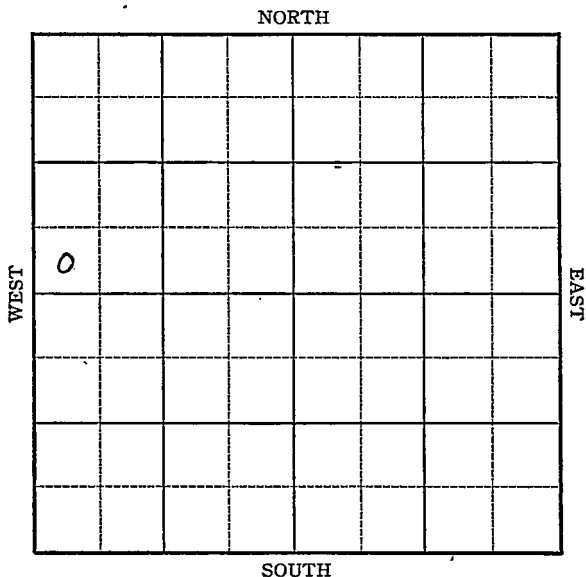

Sec. 29 Twp. 26 R. 12-W

Well No. #2 Hoene Farm  
Skelly Company


\_\_\_\_\_ Ft. from N. Line

330 Ft. from S. Line

\_\_\_\_\_ Ft. from E. Line

330 Ft. from W. Line

Carmi Pool

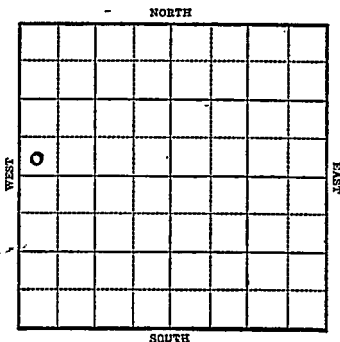

1943 *Elev. 1918* R E P O R T

7/28 Location  
8/4 Derrick  
8/11 8" @ 449'  
Drlg. 990'  
8/18 Drlg. 2150'  
8/25 Drlg. 3500'  
9/1 Drlg. 4226'  
9/8 Viola 4111  
Arb 4284  
T.D. 4290  
9/15 5" @ 4286½ rust  
Arb 4284  
5" @ 4286½  
4500 acid  
Depth Pot. 3024  
Max 3000  
T.D. 4311  
Gravity 40.9

COMPLETION

**KANSAS**

Pratt

Map No. 47 Sec. 29 Twp. 26 R. 12W

Well No. 2 Hoene

Skelly

Company

FIRST REPORT

Contractor

SW NW

SECTION PLAT

\_\_\_\_\_ Ft. from N. Line

330

Ft. from S. Line

\_\_\_\_\_ Ft. from E. Line

330

Ft. from W. Line


**CARMI POOL**

Location XXX

Rig up \_\_\_\_\_

Drilling and Remarks: \_\_\_\_\_

**RECORD**

Cased \_\_\_\_\_ in., \_\_\_\_\_ ft.

Sand \_\_\_\_\_

Gas \_\_\_\_\_

Oil \_\_\_\_\_

Total Depth \_\_\_\_\_

**PRODUCTION**

1st 24 hrs. Nat. \_\_\_\_\_

1st 24 hrs. after shot \_\_\_\_\_

Gas \_\_\_\_\_ Cu. Ft.

Dry Hole \_\_\_\_\_

Abandoned \_\_\_\_\_

Date

JUL 28 1942 19

S. J. LEWIS Scout

**KANSAS**

Map No. 47 Sec. 29 Twp. 26 R. 12W

Well No. 2 Hoene

Skelly Company

**COMPLETED** Contractor

SW NW

SECTION PLAT

\_\_\_\_\_ Ft. from N. Line

330 Ft. from S. Line

\_\_\_\_\_ Ft. from E. Line

330 Ft. from W. Line

0			

Carmi Pool

Location \_\_\_\_\_

Rig up \_\_\_\_\_

Drilling and Remarks:

*Per 4284*  
*5" @ 4286 1/2*  
*4500 acid*  
*Sept 16 1943*  
*8024*  
*Max 3000*  
*H.E. Gr.*

RECORD

Cased \_\_\_\_\_ in., \_\_\_\_\_ ft.

Sand \_\_\_\_\_

Gas \_\_\_\_\_

Oil \_\_\_\_\_

Total Depth 4211

PRODUCTION

1st 24 hrs. Nat. \_\_\_\_\_

1st 24 hrs. after shot \_\_\_\_\_

Gas \_\_\_\_\_ Cu. Ft.

Dry Hole \_\_\_\_\_

Abandoned \_\_\_\_\_

Date

SEP 15 1943 19

S. J. LEWIS Scott