

KANSAS


Pratt

FORM 51 5M 1-42 PETROL

Section 29 Township 26 Range 12-W

Well No. #2 Knop

Company Shell

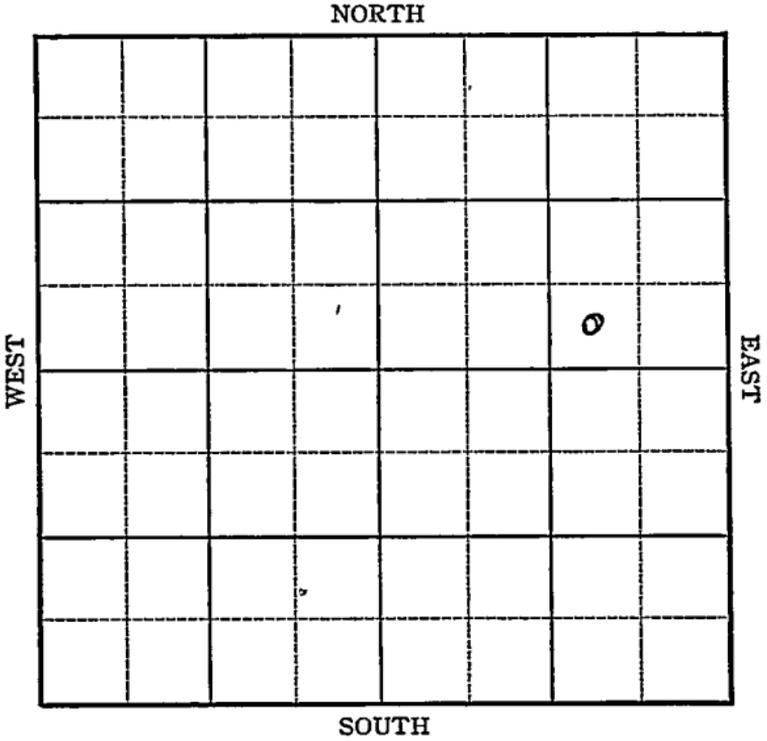

Sec. 29 Twp. 26 R. 12-W

Well No. #2 Knop Farm

Shell Company

Carmi


 Ft. from N. Line

330 Ft. from S. Line

990 Ft. from E. Line

 Ft. from W. Line

Elev. 1916

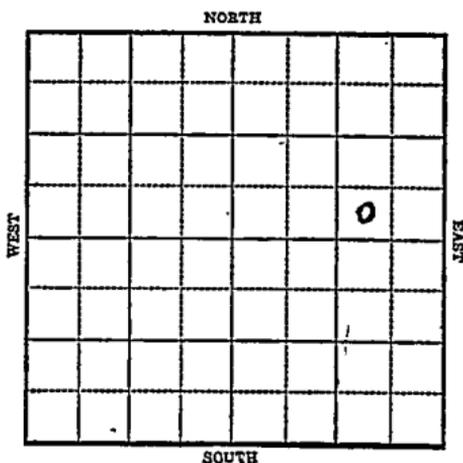

1943

R E P O R T

7/21 8" @ 859' -
Drlg. 2047'

7/28 Drlg. 3328'

8/4 Topeka 3168
Lans 3679
Drlg. 3853'

8/18 Arb 4258
4" @ 4261
1500 acid
Echo Pot. 3000
T.D. 4306'
Grav. 40

COMPLETED

