

KANSAS


Pratt

FORM 51 5M PETROL

Section 29 Township 26 Range 12-W

Well No. #4 Knop

Company Shell

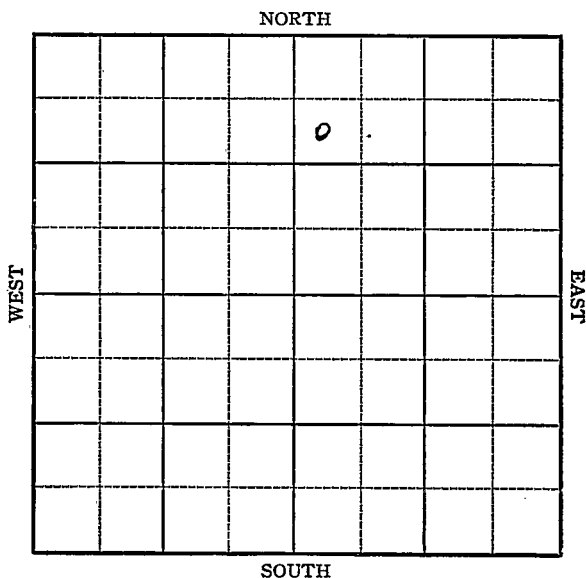


KANSAS

Pratt

Sec. 29 Twp. 26 R. 12-WWell No. #4 Knop FarmShell Company

NORTH

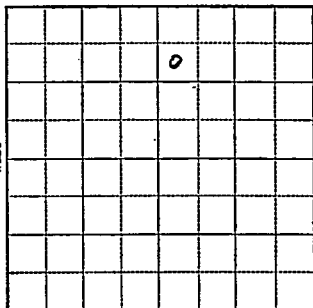990 Ft. from N. Line Ft. from S. Line Ft. from E. Line330 Ft. from W. LineElev. 1920

1943

R E P O R T

10/20 Location

10/27 "

11/3 "

11/10 "

11/17 "

11/24 "

12/ 1 "

12/8 "

12-15 "

12/22 "

12-29 "

ABANDONED


KANSAS

Map No. 47 Sec. 29 Twp. 26 R. 12WWell No. 4 KnopShell Company

FIRST REPORT Contractor

SW NW NE

SECTION PLAT

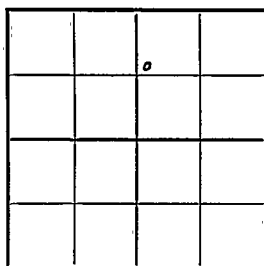990 Ft. from N. Line Ft. from S. Line Ft. from E. Line330 Ft. from W. LineGarmi PoolLocation XRig up

Drilling and Remarks:

RECORD

Cased in., ft.Sand Gas Oil Total Depth

PRODUCTION

1st 24 hrs. Nat. 1st 24 hrs. after shot Gas Cu. Ft.Dry Hole Abandoned

Date

OCT 20 194319S. J. LEWIS Scout

KANSAS
 Map No. 29 Sec. 26 Twp. 12W
 Well No. 4 Knop

Shell Company

ABANDONED Contractor

SW NW NE


SECTION PLAT

990 Ft. from N. Line

 Ft. from S. Line

 Ft. from E. Line

330 Ft. from W. Line

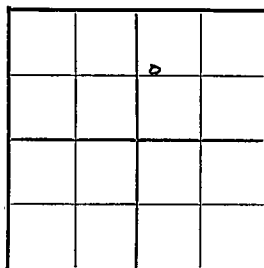

Carmi Pool

Location ✓

Rig up

Drilling and Remarks:

RECORD

Cased in., ft.

Sand

Gas

Oil

Total Depth

PRODUCTION

1st 24 hrs. Nat.

1st 24 hrs. after shot

Gas Cu. Ft.

Dry Hole

Abandoned Loc

Date

DEC 2 9 1943 19

S. J. LEWIS Scout