


Section 29 Township 26 Range 12-W

Well No. #1 C. Knop

Company Shell

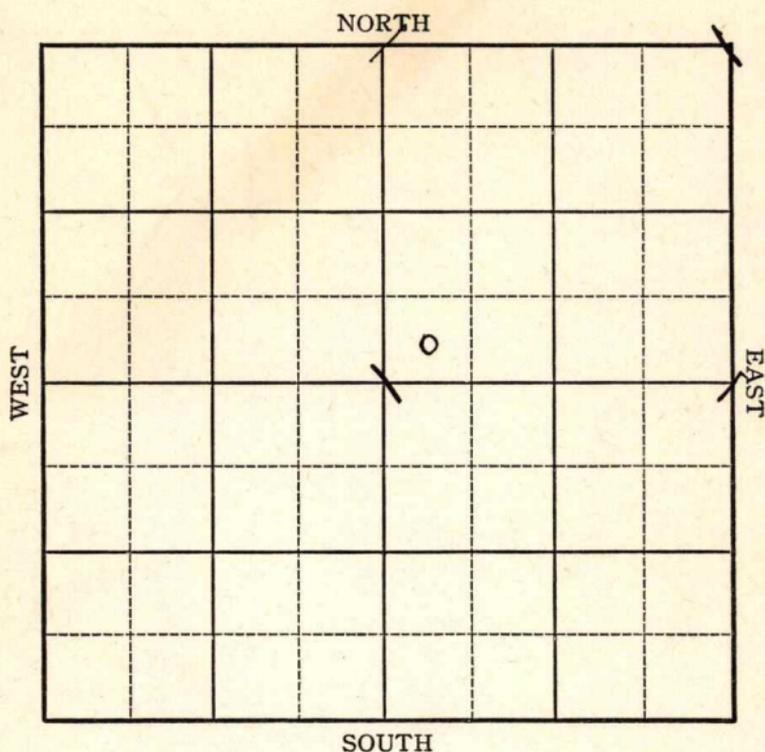

C.W.W.O. KANSAS

Pratt **KANSAS**

Sec. 29 Twp. 26 R. 12-W

Well No. #1 C. Knop Farm _____

Shell Company _____

Carmi


_____ Ft. from N. Line

330 Ft. from S. Line

_____ Ft. from E. Line

409 Ft. from W. Line

Elev. 1925

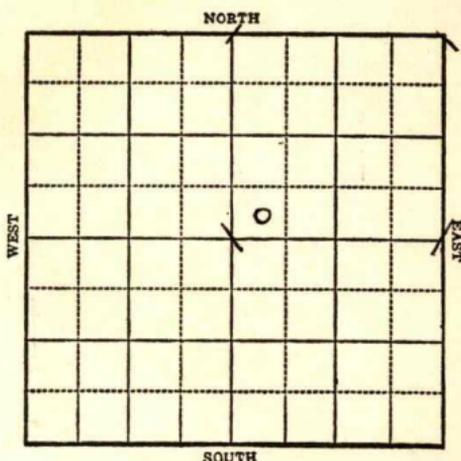

1943 **Elev. 1925'** R E P O R T

- 6/9 Cellar
- 6/16 8" @ 802'
Drlg. 902'
- 6/23 Drlg. 2832'
- 6/30 **Topeka 3169**
Lans 3686
Drlg. 3950'
- 7/7 **Viola 4111**
Simp. 4176
Arb. 4270
T.D. 4295'
4" @ 4273' RUST
- 7/14 TD 4315'
1500 acid
Flow 6l oil in 1 hr.
- 7/21 **Arb. 4270**
4" @ 4273'
T.D. 4315'
1500 acid
Echo Pot 60700
Max. 3000
Gravity 40.9

COMPLETED

OVER

1952
8/13

Q.W.W.O.
Lans. 3686' 4111' Simp 4176'
Arb. 4270' prod.
OTD 4315' 4" @ 4273' PB 4190'
112/4115-43 40/4115-25

8/20

2000 A NS PB 4046
32/3926-34 S/6 BF 14 hrs.
2% wtr 3000 A F 6 BO 4 hrs.
3/4" ck. F 12 BO 12 hrs.

8/27

Oil Well TD 4315'
Lans. 3686 Viola 4111
Simp. 4176 Arb. 4270
OTD 4315' 5" @ 4273 PB 4190
112/4115-43 40/4115-25
SSE 2000 A PB 4046 32/3926-34
S/6 bf 14 hr. 2% wtr. 3000 A
F/6 bo 4 hr. F/12 bo 12 hr.
Comp. 17 bopd 2 mcfg

COMPLETED

Pratt

KANSAS
Map No. 47 Sec. 29 Twp. 26 R. 12W

Well No. 1 C. Knop

Shell Company

FIRST REPORT Contractor

SW NE


SECTION PLAT

 Ft. from N. Line

330 Ft. from S. Line

 Ft. from E. Line

409 Ft. from W. Line

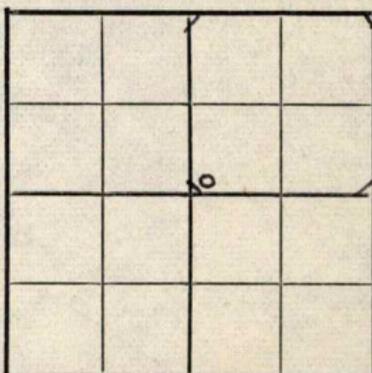

CARMI POOL

Location

Rig up

Drilling and Remarks:

Cellar

RECORD

Cased in., ft.

Sand

Gas

Oil

Total Depth

PRODUCTION

1st 24 hrs. Nat.

1st 24 hrs. after shot

Gas Cu. Ft.

Dry Hole

Abandoned

Date

JUN 9 1943 19

S. J. LEWIS Scout

