

KANSAS


FORM 51 5M 10-41 PETROL

Pratt

Section 29 Township 26 Range 12-W

Well No. #2 Brown "B"

Company Hollow Drilling

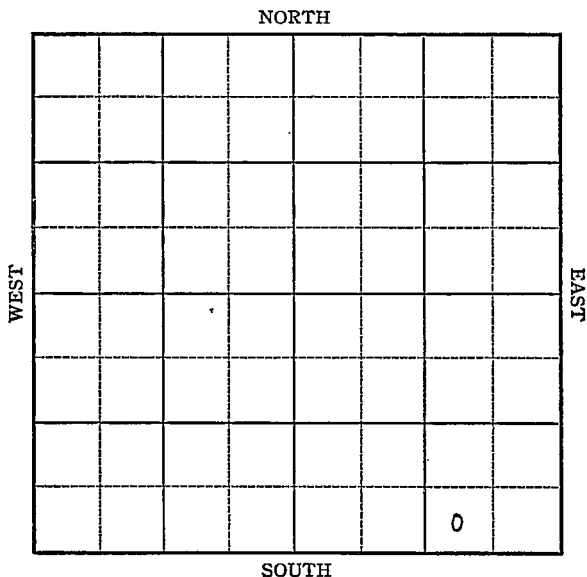

Sec. 29 Twp. 26 R. 12-W

Well No. #2 Brown "B" Farm _____

Hollow Drilling Company _____


Iuka

_____ Ft. from N. Line

330 Ft. from S. Line

990 Ft. from E. Line

_____ Ft. from W. Line

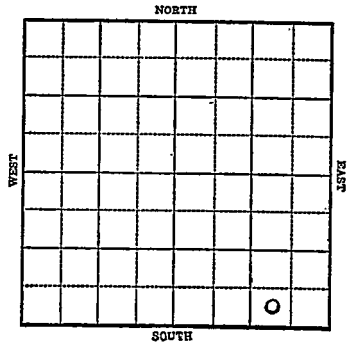

Elev. 1911

1943

R E P O R T

- 3/3 Location.
- 3/10 Anhy 733
8" Casing set 469'
Drlg. 1053'
- 3/17 Drlg. 2020'
- 3/24 Topeka 3165
Drlg. 3400'
- 3/31 Lans 3672
Arb 4262
TD 4264 no shows.
- 4/14 Arb. 4262
5" @ 4264'
T.D. 4305'
Bomb Pot. 5756'
Max 3000
Gravity 36

COMPLETED

x

KANSAS ~~7~~ Pratt
 Map No. 27 Sec. 29 Twp. 26 R. 12W

Well No. 2 Brown "B"

Hollow Drilling Company

FIRST REPORT Contractor

SW SE SE

SECTION PLAT

 Ft. from N. Line

330 Ft. from S. Line

990 Ft. from E. Line

 Ft. from W. Line

| | | | |
|--|--|--|---|
| | | | |
| | | | |
| | | | |
| | | | o |

IUKA POOL

Location XXX

Rig up

Drilling and Remarks:

RECORD

Cased in., ft.

Sand

Gas

Oil

Total Depth

PRODUCTION

1st 24 hrs. Nat.

1st 24 hrs. after shot

Gas Cu. Ft.

Dry Hole

Abandoned

Date

MAR 3 1943 19

S. J. LEWIS Scout

KANSAS

Pratt

Map No. 47 Sec. 29 Twp. 26 R. 12WWell No. 2 Brown "B"Hollow Drilling CompanyCOMPLETED Contractor

SW SE SE

SECTION PLAT

| | | | |
|--|--|--|---|
| | | | |
| | | | |
| | | | |
| | | | e |

_____ Ft. from N. Line

330 Ft. from S. Line990 Ft. from E. Line

_____ Ft. from W. Line

TUKA POOL

Location _____

Rig up _____

Drilling and Remarks:

Cor #42625" #4264Bore # 25756May 300036° SW

RECORD

Cased _____ in., _____ ft.

Sand _____

Gas _____

Oil _____

Total Depth 4305'

PRODUCTION

1st 24 hrs. Nat. _____

1st 24 hrs. after shot _____

Gas _____ Cu. Ft.

Dry Hole _____

Abandoned _____

Date

APR 14 1943 19

S. J. LEWIS Scout