O.W.P.B.


FORM 51 5M BRIX

KANSAS Pratt County

Section 29 Township 26 Range 12W

Well No. #1 Petrowsky

Company Bishop Oil

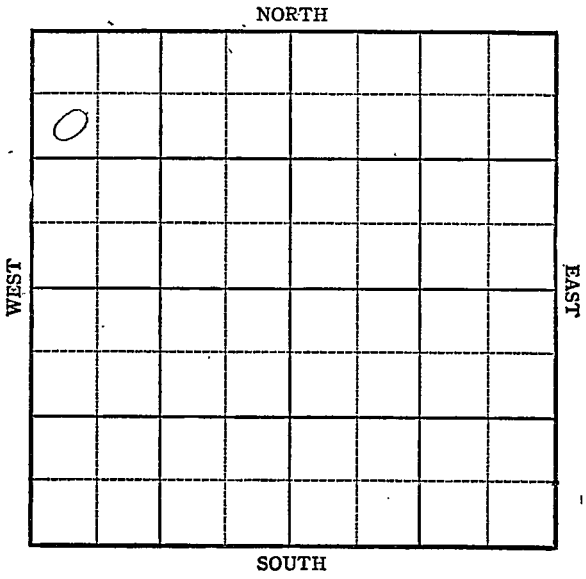

FORM 252-A
5M 9-44 PETROL

O. W. P. B. KANSAS

Pratt County

Sec. 29 Twp. 26 R. 12W

Well No. #1 Petrowsky Farm

Bishop Oil Company

Carmi


990 Ft. from N. Line

Ft. from S. Line

Ft. from E. Line

330 Ft. from W. Line

SW NW NW Elev. 1914

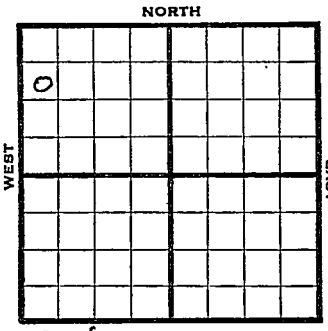

1944	REPORT
11/8	Location Shell farmout
11/16	Derrick
11/24	8" @ 357 DDrlg.1051
11/299	Drlg. 2708
12/6	Lans 3686 Miss 4054 Kind 4088 Viola 4072 Simp 4184 Arb. 4301-4306 TD Tun csg.
12/14	5" @ 4298' RUST
12/21	" " "
12/29	TD 4311' swb 5 oil in 2 hrs.
1945 1/3	" " " " " "
1/10	" " " " " "
1/17	Pump 3½ oil Ph 8 hrs
1/26	" " " " "

OVER

1945

1/31 Arb. 4301
5" @ 4298
TD 4311
Pump 313 Pot.
No water.
Grav. 40.9

COMPLETED

1953
2/4 O. W. P. B.
Oil well TD 4315' Lans. 3666',
Miss. 4054', H. 4084', Viola 4092',
Simp. 4184', Arb. 4301'
OTD 4315'. 5" @ 4398 SP 4280
96/4134-64 2000 A A-frac.
S/1¼ BOPH P/29 BOPD went to wtr.
SP 4185' 20/3960-65 5 BWPH
SP 3948 36/3917-26 FU 635' oil
115' wtr. 500 A S/5¼ BO 1-3/4 BWPH
3½ hr. P/12 BO 48 BWPH
Comp. 16 BOPD 91 BW

FIRST REPORT
COMPLETED

FORM 26 200 BKS. 2-44 PETROL

Pool Name Carmi

Map No. K- Sec. 29 Twp. 26 R. 12W

Well No. 1 Petrowsky

Bishop Oil Company

COMPLETED Contractor

SW NW NW


990 Ft. from N. Line

Ft. from S. Line

Ft. from E. Line

330 Ft. from W. Line

SECTION PLAT

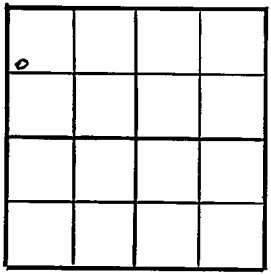

Pratt

Location

Rig up

Drilling and Remarks:

Ac & 4301

5 TD 4298.

Penny 313 BS

No Water

40 E Gr

RECORD

Cased in., ft.

Sand

Gas

Oil

Total Depth 4311

PRODUCTION

1st 24 hrs. Nat.

1st 24 hrs. after shot

Gas Cu. Ft.

Dry Hole

Abandoned

Date

JAN 31 1945 19 S. J. LEWIS Scout

FORM 26 200 BKS 1-44 PETROL

Pool Name Cami

Map No. 47 Sec. 29 Twp. 26 R. 12W

Well No. 1 Petrowsky

Bishop Oil Company

FIRST REPORT Contractor

SW NW NW


990 Ft. from N. Line

____ Ft. from S. Line

____ Ft. from E. Line

330 Ft. from W. Line

SECTION PLAT

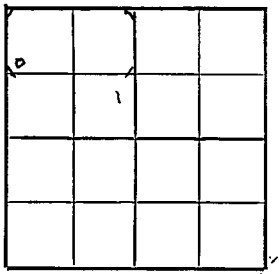

Pratt

Location X

Rig up

Drilling and Remarks:

Shell Farmout

RECORD

Cased ____ in., ____ ft.

Sand

Gas

Oil

Total Depth

PRODUCTION

1st 24 hrs. Nat.

1st 24 hrs. after shot

Gas ____ Cu. Ft.

Dry Hole

Abandoned

Date

NOV 8 1944 19 S. J. LEWIS Scout