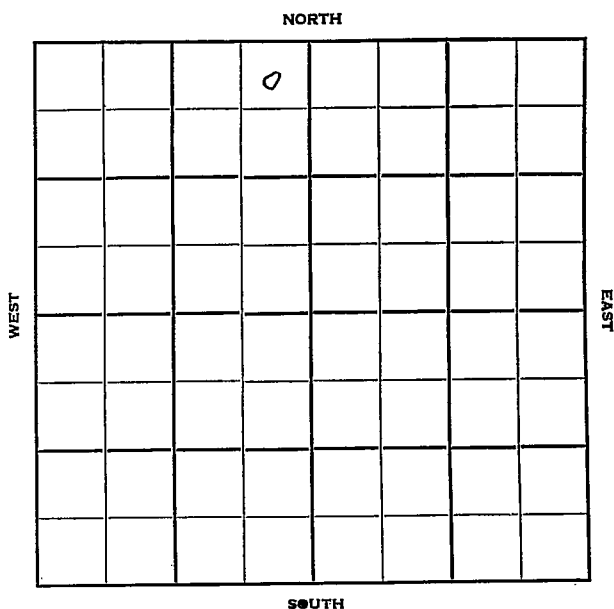



Section 29 Township 26 Range 12WWell No. #2 PetrowskyCompany Transit Corp.

Pratt

KANSAS

Sec. 29 Twp. 26 R. 12 WWell No. # 2 Petrowsky FarmTransit Corp. CompanyIuka Contractor330 Ft. from N. Line Ft. from S. Line330 Ft. from E. Line Ft. from W. Line

NE NE NW

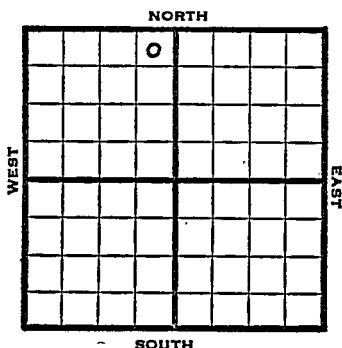

1952 Elev. 1915' REPORT

1/9 Spud 12-24-51
8" @ 410'
Heeb 3489'
Br. L 3662'
Lans. 3687'
DST 3845-75, 1 hr, 370' HOCM plus 60'
oil, 940#
DST 3900-24'

2/6 TD 4327 PB 3956
5" @ 4319 POP

2/13 NR

2/20 "

3/5 Spud 12-24-51
Oil Well TD 4327
8" @ 410 Heeb. 3489
Br Li 3662 Lans. 3687
DST 3845-75 open 1 hr. rec. 370' HOCM
60' oil
DST 3900-24 open 1 hr. rec. 145' O&GCM
30' who & gcm Miss. 4050 Viola 4087
Simp. 4193 Arb. 4316-19
5" @ 4319' DD 4327 250 A wtr.
PB 4306 19/ 4233-39 wtr. PB 3956
19/ 3916-20 S/ 2 bwph 500 A
S/ 1 boph 1000 A S/ 1½ boph
S/ 2½ boph Comp. 99 bopd 21% wtr.

COMPLETED

County Pratt State Kansas
 Sec. 29 (Blk. 26) (Sur. 12W) Map No.
 Operator Transit Corp.
 Well No. 2 Farm Petrowsky
 Elev. 1915 Location NE NE NW

		0			

330 Ft. From N Line NW330 Ft. From E Line Quarter

1st. Report

Completion MAR 5 1952Remarks Iuka PoolSpudding Date 12-24-51Drlg. Data Oil well TD 4327

8" @ 410 Heeb. 3489 Br. lime 3662

Lans. 3687 DST 3845-75 open 1 hr.

Rec. 370' hocm 60' oil DST 3900-24

open 1 hr. Rec. 145' o & gcm 30' who &

gcm Miss. 4050 Viola 4087 Simp. 4193

Arb. 4316-19 5" @ 4319 DD 4327 250 A

water PB 4306 19/ 4233-39 water

PB 3956 19/ 3916-20 S/ 2 bwph 500 A

S/ 1 boph 1000 A S/ 1½ boph S/ 2½ boph

Comp. 99% bopd 21% water

J. G. McGEHEE