

KANSAS

Pratt

FORM 51 5M 1-42 PETROL

Section 29 Township 26 Range 12-W

Well No. #2 Strueder (*Strueder*)

Company Shell

						0	

NORTH

WEST

EAST

SOUTH

KANSAS


Pratt

Sec. 29 Twp. 26 R. 12-WWell No. #2 Strueder FarmShell Company

Iuka

1023 Ft. from N. Line Ft. from S. Line996 Ft. from E. Line Ft. from W. Line

Elev. 1911

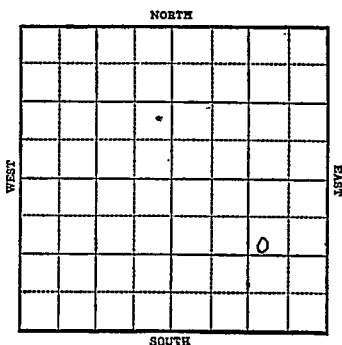

1943

R E P O R T

4/21 8" @ 784'
Drlg. 1790'

4/28 Drlg. 3408'

5/5 Topeka 3156
Lans. 3671
4113' fsg. drill pipe.

5/12 T.D. 4135' drilling on iron.

5/19 Viola 4087
Arb. ~~4259~~ 4256
T.D. 4263' Run csg.

5/26 4" @ 4258'
T.D. 4260' RUST

6/2 T.D. 4310' 1000 acid
Flow 75 oil per hr. - 2 hrs.

6/9 4" @ 4258'
Arb. 4256'
T.D. 4310'
1000 gal. acid
Depth Pot. 69721
Max. 3000
Gravity 40.9

COMPLETED

~~KANSAS~~
 Map No. 29 Sec. 29 Twp. 26 R. 12W
 Well No. 2 Strueder

Shell Company

FIRST REPORT Contractor

SW NE SE

1023 Ft. from N. Line

Ft. from S. Line

996 Ft. from E. Line

Ft. from W. Line

SECTION PLAT

IUKA POOL

Location

Rig up

Drilling and Remarks:

8"-784'

Dr lg. 1790'

RECORD

Cased in., ft.

Sand

Gas

Oil

Total Depth

PRODUCTION

1st 24 hrs. Nat.

1st 24 hrs. after shot

Gas Cu. Ft.

Dry Hole

Abandoned

Date

APR 21 1943 19 S. J. LEWIS Scout

KANSAS

Pratt

Map No. 47 Sec. 29 Twp. 26 R. 12WWell No. 2 StruederShell


Company

COMPLETED

Contractor

SW NE SE

SECTION PLAT

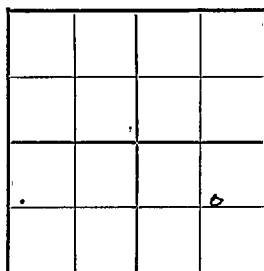1023 Ft. from N. Line Ft. from S. Line996 Ft. from E. Line Ft. from W. Line

IUKA POOL

Location

Rig up

Drilling and Remarks:

Cor Y 4256.
4" @ 4258
1000 acid
Sept 18 1942
Max 3000
41 E Gr

RECORD

Cased in., ft.Sand Gas Oil Total Depth 4210

PRODUCTION

1st 24 hrs. Nat. 1st 24 hrs. after shot Gas Cu. Ft.Dry Hole Abandoned

Date

JUN 9 1943 19

S. J. LEWIS Scout

O.W.W.O.

FORM 513 SUNRAY

County Pratt Elev. 1917
 Sec. 29 Twp. 26 Rge. 12W
 Company Shell Oil
 Farm Name E. Stueder No. 2

TOPS	DEPTH	LOG	DATUM	Loc. in Sec.
Anh.				SW NE SE
TP.	3156			<u>O.W.W.O.</u>
H.				1023' NL
Tr.				926' EL
Dg.				Geol.
BL.	3674			Contr. ()
L.				Pool
K.C.				Tuka-Carmi
B.K.C.				FIRST REPORT
Ce.				COMPLETE
C.				10
M.				FEB 13 57
M.				
K.				
Mz.				
Me.				
V.				
S.				
S.	4256			
A.				
R.				
Pe.				
G.				
T.D.				

Date Comm.

OTD 4310 4" @ 4258 PB 3966

56/ 3948-62 S/ 10 bo 2000 A

F/ 64 bo 30 bw F/ 45 bo 10 bw 24 hr.

Comp. F/ 40 bopd NW

26