KANSAS


Pratt

FORM 51 5M 1-42 PETROL

Section 29 Township 26 Range 12-W

Well No. #4 Stueder

Company Champlin Refining

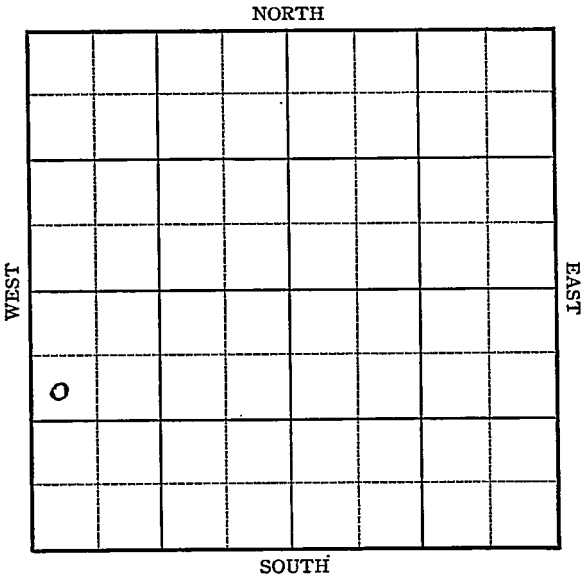

FORM 252-A
5M- 9-42 GASS

KANSAS

Pratt

Sec. 29 Twp. 26 R. 12-W

Well No. #4 Strueder Farm

Champlin Refining Company

Iuka


990 Ft. from N. Line

Ft. from S. Line

Ft. from E. Line

330 Ft. from W. Line

Elev 1916

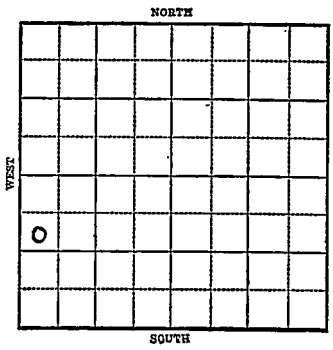

1943	REPORT
4/21	Location.
4/28	ROG
5/5	Derrick
5/12	"
5/19	"
5/26	"
6/2	"
6/9	"
6/16	10" @ 772 Drlg. 1820'
6/23	Drlg. 3320'
6/30	Drlg. 4200'
7/7	Arb 4284 T. D. 4313 5" @ 4294 Rust
7/15	Arb 4300 corrected 5" @ 4300 T.D. 4318 HFO in 13 hrs. 5000 acid
7/21	Arb. 4300 5" @ 4300 T.D. 4318' 5000 acid Echo Pot 6828 Max. 3000 Gravity 40.9 COMPLETED

Form 26 200 Bks 5-42 Petrol

KANSAS

Pratt

Map No. 29 Sec. 29 Twp. 26 R. 12W

Well No. 4 Strueder

Champlin Refining Company

FIRST REPORT Contractor

SW NW SW


990 Ft. from N. Line

Ft. from S. Line

Ft. from E. Line

330 Ft. from W. Line

SECTION PLAT

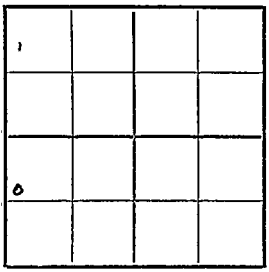

IUKA POOL

Location XXX

Rig up

Drilling and Remarks:

RECORD

Cased in., ft.

Sand

Gas

Oil

Total Depth

PRODUCTION

1st 24 hrs. Nat.

1st 24 hrs. after shot

Gas Cu. Ft.

Dry Hole

Abandoned

Date

APR 2 1 1943 19 S. J. LEWIS Scout

Form 26 200 Bks 5-42 Petrol Pratt

KANSAS


Map No. 47 Sec. 29 Twp. 26 R. 12W

Well No. 4 Strueder

Champlin Refining Company

COMPLETED Contractor

SECTION PLAT

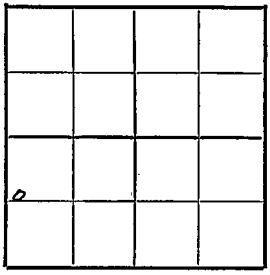

990 SW NW SW Ft. from N. Line

Ft. from S. Line

Ft. from E. Line

330 Ft. from W. Line

IUKA POOL

Location

Rig up

Drilling and Remarks:

Cir Y 4300
5" @ 4300
5000 Acid
Echo B Y 6828
Map 3000

40 E/2

RECORD

Cased in., ft.

Sand

Gas

Oil

Total Depth 4318

PRODUCTION

1st 24 hrs. Nat.

1st 24 hrs. after shot

Gas Cu. Ft.

Dry Hole

Abandoned

Date

JUL 21 1943 19

S. J. LEWIS Scout