


pratt

Section 30 Township 26 Range 12-W

Well No. #2 Petrowsky

Company Texas

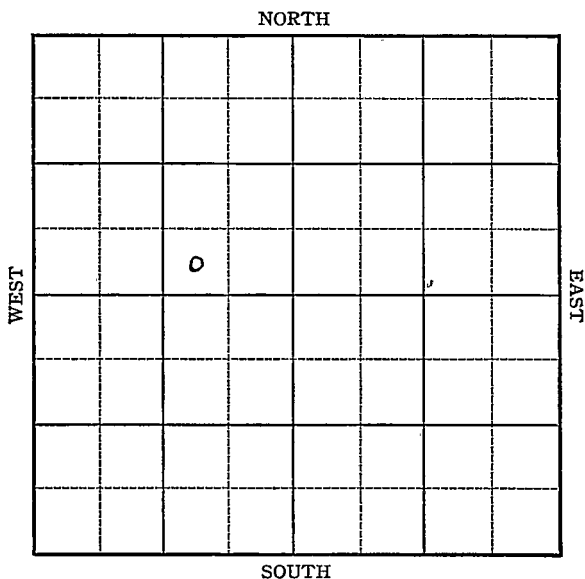

KANSAS

Pratt

Sec. 30 Twp. 26 R. 12-W

Well No. #2 Petrowsky Farm

Texas Company

Carmi

NORTH


Ft. from N. Line

330 Ft. from S. Line

990 Ft. from E. Line

Ft. from W. Line

Elev. 1939

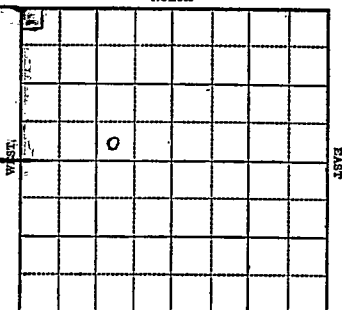

1943

R E P O R T

6/9 Location.
6/16 "
6/23 8" @ 486'
WOC
6/30 Drlg. 2691'
7/7 Drlg. 3938'
7/14 Drlg. 4224'
7/21 Arb. 4295-96 T.D.
5" @ 4295'
RUST
7/28 T.D. 4322'
2000 acid. Flow 224 oil 6 hrs.
8/4 Arb. 4295
5" @ 4295'
T.D. 4322'
2000 acid
Depth Pot 8606
Max. 3000
Gravity 40.9

COMPLETED

KANSAS**Pratt**Map No. 47 Sec. 30 Twp. 26 R. 12WWell No. 2 PetrowskyTexas

Company

FIRST REPORT

Contractor

SW SE NW

SECTION PLAT

	0		

_____ Ft. from N. Line

330 Ft. from S. Line990 Ft. from E. Line

_____ Ft. from W. Line

GARM POOLLocation ☒

Rig up _____

Drilling and Remarks:

RECORD

Cased _____ in., _____ ft.

Sand _____

Gas _____

Oil _____

Total Depth _____

PRODUCTION

1st 24 hrs. Nat. _____

1st 24 hrs. after shot _____

Gas _____ Cu. Ft.

Dry Hole _____

Abandoned _____

Date

JUN 9 1943 19**S. J. LEWIS**

Scout

KANSAS

Pratt

Map No. 47 Sec. 30 Twp. 26 R. 12WWell No. 2 Petrowsky

Texas

Company

COMPLETED

Contractor

SW SE NW

SECTION PLAT

_____ Ft. from N. Line

330 Ft. from S. Line990 Ft. from E. Line

_____ Ft. from W. Line

	0		

CARMI POOL

Location _____

Rig up _____

Drilling and Remarks:

*CEL 4295**5" C 4295**2000 cas l**Sept 1928 5606**Max 3000**40 F Gr*

RECORD

Cased _____ in., _____ ft.

Sand _____

Gas _____

Oil _____

Total Depth 4322

PRODUCTION

1st 24 hrs. Nat. _____

1st 24 hrs. after shot _____

Gas _____ Cu. Ft.

Dry Hole _____

Abandoned _____

Date

AUG 4 1943 19

S. J. LEWIS Scout

O.W.W.O.

FORM 513 SUNRAY

County Pratt Elev. 1939 DF
 Sec. 30 Twp. 26 Rge. 12W
 Company The Texas Co.
 Farm Name Petrowsky No. 2

TOPS	DEPTH	LOG	DATUM	Loc. in Sec.
Anh.				SW SE NW
Tr.				(OWWO)
Dg.				
Bl.				
L.				Geol.
K.C.				Contr.
B.K.C.				
Ce.				
C.				
M.				Pool
M.				<u>Tuka Carmi</u>
K.				
Mz.				
Me.				
V.	<u>4125</u>			FIRST REPORT
S.				
S.				
A.				
R.				
Pe.				
G.				
TD	<u>OTD</u>	<u>4322</u>		COMPLETE

Date Comm. PB 4227, 27/4207-16, ns, 250 MCA,
 Frac ga 3380 mcf, PB 4182, 64/4144-64,
 Tst 1 gal oil + 19 gw 3 hrs, 500A, fl 14.75
 bo nw 7 hrs. + 3137 mcf, fl 61 bopd nw +
 6665 mcf,
 New Info - Frac 20 x 20 rec 1d, fl 246 bopd
 nw + 514 mcf, $\frac{1}{2}$ " ch, COMPLETE

26