

KANSAS


Pratt

FORM 51 5M 1-42 PETROL

Section 31 Township 26 Range 12-W

Well No. #1 C. L. Binger

Company Magnolia

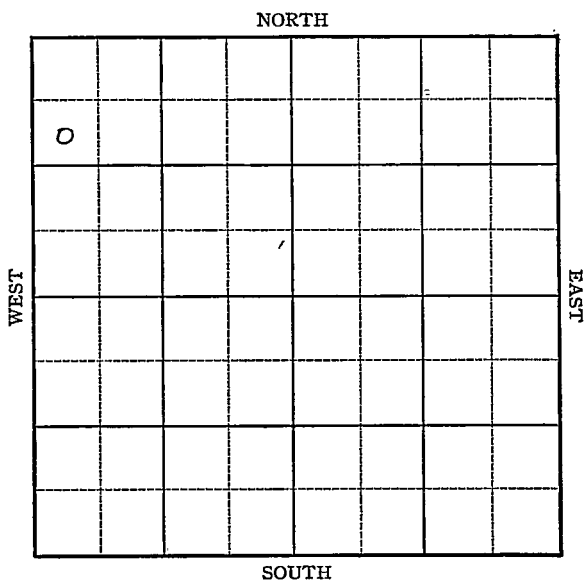

KANSAS


Pratt

Sec. 31 Twp. 26 R. 12-WWell No. #1 C. L. Binger FarmMagnolia Company

Iuka

990 Ft. from N. Line Ft. from S. Line Ft. from E. Line330 Ft. from W. Line

Elev. 1926

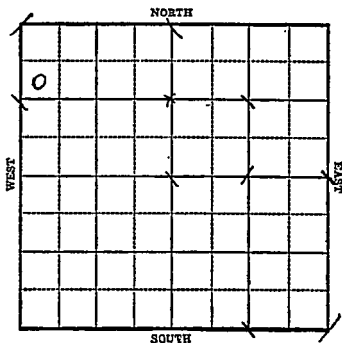

1943

R E P O R T

3/24 Cellar.

3/31 Rotary.

4/7 10" - 636

Drlg. 2410

4/14 Drlg. 3696'

4/21 Arb. 4297

T.D. 4303

5" - 4301

RUST

4/28 TD 4315'

2000 gal. acid

Flow 25 bbls oil per hour.

5/5 Arb. 4297'

5" @ 4301'

T.D. 4315'

2000 gal. acid

Max. 3000

Gravity 40.9

COMPLETED

KANSAS

Pratt


Map No. 47 Sec. 31 Twp. 26 R. 12WWell No. 1 C. L. BingerMagnolia Company

FIRST REPORT

Contractor

SW NW NW

SECTION FLAT

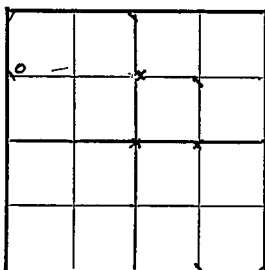990 Ft. from N. Line Ft. from S. Line Ft. from E. Line330 Ft. from W. Line

IUKA POOL

Location Rig up

Drilling and Remarks:

Cellar

RECORD

Cased in., ft.Sand Gas Oil Total Depth

PRODUCTION

1st 24 hrs. Nat. 1st 24 hrs. after shot Gas Cu. Ft.Dry Hole Abandoned

Date

MAR 24 1943

19

S. J. LEWIS

Scout

KANSAS Pratt

Map No. 47 Sec. 31 Twp. 26 R. 12WWell No. 1 C. L. BingerMagnolia

Company

COMPLETED

Contractor

SW NW NW

SECTION PLAT

6	-		

990 Ft. from N. Line

Ft. from S. Line

Ft. from E. Line

330 Ft. from W. Line

IUKA POOL

Location

Rig up

Drilling and Remarks:

*Per 4297**5" @ 4301**2000 Barrels**Depth 4255**Max 3000**40 I Gr*

RECORD

Cased _____ in., _____ ft.

Sand _____

Gas _____

Oil _____

Total Depth 4315

PRODUCTION

1st 24 hrs. Nat. _____

1st 24 hrs. after shot _____

Gas _____ Cu. Ft.

Dry Hole _____

Abandoned _____

Date

MAY 5 1943

19

S. J. LEWIS

Scout