

KANSAS


FORM 51 5M 1-42 PETROL

Pratt

Section 30 Township 26 Range 12-W

Well No. #1 Sittner

Company Shell

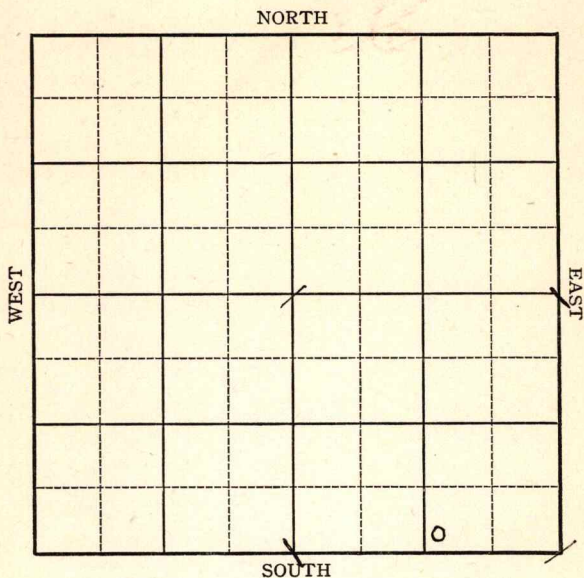

KANSAS

Pratt

Sec. 30 Twp. 26 R. 12-W

Well No. #1 Sittner Farm

Shell Company

Carmi


Ft. from N. Line

330 Ft. from S. Line

1000 Ft. from E. Line

Ft. from W. Line

Elev 1919

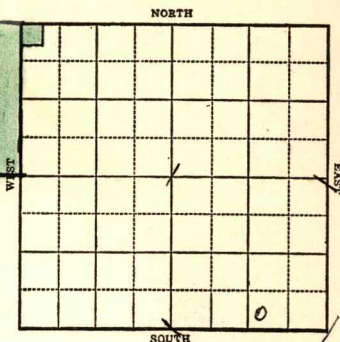

1943

R E P O R T

6/9 8" @ 835'
Drlg. 1513'

6/16 Drlg. 3258'

6/23 Lans 3704
Drlg. 4089'

6/30 Viola 4118
Arb. 4286
T.D. 4306'
5" @ 4289' RUST

7/7 Arb. 4286
5" @ 4289
T.D. 4316
2000 acid
Depth Pot 4565
Max 3000
Gravity 40.9

COMPLETED

26
O. W. P. B.

S-513-A

CO. Pratt ELEV. 1919
SEC. 30 TWP. 26 RGE. 1 2W
COMPANY Shell Oil NO. 1

DEC 26 1957

FIRST REPORT

COMPLETE

FARM Sittner

LOC. SW SE SE

OWPB

Ls. 3704

Arb. 4286

GEOLOGICAL

CONTR.

POOL

SPUD

OTD 4316 4" @ 4289

PB 3887 24/ 3848-54

SSG 2000 A

P & F/ 9 bo 36 bw

Comp. 5 bopd 8 bw

CO.

LSE.

NO.

SEC.

TWP.

RGE.

KANSAS

Map No. 47 Sec. 30 Twp. 26 R. 12WWell No. 1 Sittner

Shell


Company

FIRST REPORT

Contractor

SW SE SE

SECTION PLAT

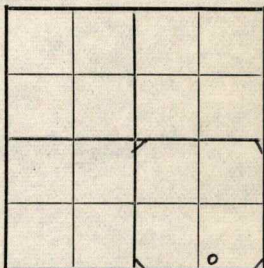

Ft. from N. Line

330 Ft. from S. Line1000 Ft. from E. Line

Ft. from W. Line

CARM I POOL

Location

Rig up

Drilling and Remarks:

8"-835'

Dr 1g. 1513'

RECORD

Cased _____ in., _____ ft.

Sand _____

Gas _____

Oil _____

Total Depth _____

PRODUCTION

1st 24 hrs. Nat. _____

1st 24 hrs. after shot _____

Gas _____ Cu. Ft.

Dry Hole _____

Abandoned _____

Date

JUN 9 1943 19

S. J. LEWIS


Scout

Pratt

~~KANSAS~~Map No. Sec. 30 Twp. 26 R. 12 WWell No. 1 SittnerShellCompany COMPLETEDContractor

SW SE SE

SECTION PLAT

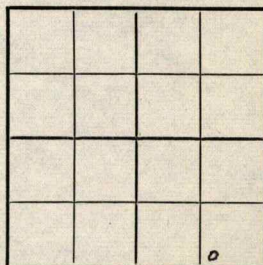 Ft. from N. Line300 Ft. from S. Line1000 Ft. from E. Line Ft. from W. LineCARMI POOLLocation Rig up

Drilling and Remarks:

*Per 4286**5" @ 4289**2000 acid**Depth Per 4565**Max 3000**40? Gr*

RECORD

Cased in., ft.Sand Gas Oil Total Depth 4316

PRODUCTION

1st 24 hrs. Nat. 1st 24 hrs. after shot Gas Cu. Ft.Dry Hole Abandoned

Date

JUL 7 1943 19S. J. LEWIS Scout