

KANSAS


Pratt

O.W.P.B.

Section 30 Township 26 Range 12 ~~W~~

Well No. #2 Sittner

Company Shell

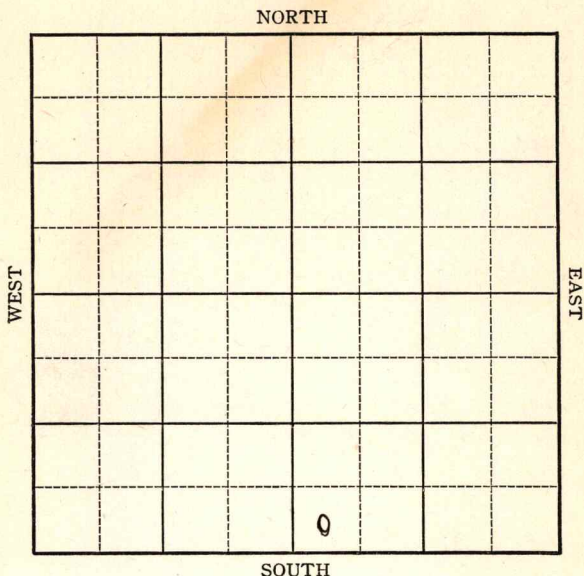

KANSAS

O. W. P. B.
Pratt



Sec. 30 Twp. 26 R. 12-W

Well No. #2 Sittner Farm

Shell Company


Carmi

 Ft. from N. Line

330 Ft. from S. Line

 Ft. from E. Line

330 Ft. from W. Line

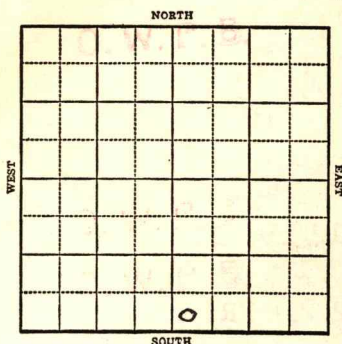

1943

Elev. 1921' R E P O R T

6/30

Drlg. 229'

7/7

8" @ 820
Drlg. 2620'

7/15

Drlg. 3820"

7/21

Lans 3717
Viols 4118
Arb 4284
T.D. 4307
Run 4"

7/28

Arb. 4284
4" @ 4287'
T.D. 4317'
1000 acid
Depth Pot 14340
Max 3000
Gravity 40.9

COMPLETED

1952

O. W. P. B.

9/4

Lans. 3717 **Viola 4118**
Simp. 4168 **Arb. 4284**
OTD 4317 4" @ 4287' PB 4243
64/ 4224-40 fsg.

9/10

Re-set plug ater fish Set plug 4270
16 BWPB PB 4247

9/17

Hydra S/ 28 BO F 41 BO 12 hrs.

9/24

NR

OVER

1952

10/1	NR
10/8	"
10/15	"
10/22	"
10/29	"
11/5	"
11/12	"
11/20	"
11/27	"
12/4	"
12/11	NR
12/18	NR
12/25	NR

1953

1/7 Gas Well

TD 4317

Lans 3717, Viola 4118, Simp 4168,
Arb. 4284

OTD 4317

4" @ 4287

PB 4243 64/4224-40, SP 4270

16 bwph PB 4247, hydro.

S/28 bo F/41 bo 12 hrs.

Comp. F/421,000 gas per day

COMPLETED

26
O. W. P. B.

S-513-A

CO. ~~Pratt~~ ELEV. 1921
SEC. 30 TWP. 26 RGE. 12W
COMPANY Shell Oil NO. 2

FIRST REPORT
DEC 26 57
COMPLETE

FARM Sittner
LOC. SW SW SE

O. W. P. B.

OWPB

Vi. 4118
Sp. 4168
Arb. 4284

GEOL.
CONTR.
POOL Iuka-Carmi
SPUD

OTD 4317 4" @ 4287
PB 4169 24/ 4112-18
40/ 4134-44 1000 A
S/ 11 bo 3 hr.
Comp. 1 bopd

CO.

LSE.

NO.

SEC.

TWP.

RGE.

J. G. McGEHEE

J. G. McGEHEE

KANSASMap No. 47 Sec. 30 Twp. 26 R. 12WWell No. 2 SittnerShell

Company

FIRST REPORT

Contractor

SW SE

SECTION PLAT

Ft. from N. Line

330

Ft. from S. Line

Ft. from E. Line

330

Ft. from W. Line

CARM I P OOL

Location

Rig up

Drilling and Remarks:

Dr1 g. 229'

RECORD

Cased _____ in., _____ ft.

Sand _____

Gas _____

Oil _____

Total Depth _____

PRODUCTION

1st 24 hrs. Nat. _____

1st 24 hrs. after shot _____

Gas _____ Cu. Ft.

Dry Hole _____

Abandoned _____

Date

JUN 30 1943 19

S. J. LEWIS

Scout

KANSAS
Map No. 47 Sec. 30 Twp. 26 R. 12WWell No. 2 Sittner

Shell


Company

COMPLETED

Contractor

SW SE

SECTION PLAT

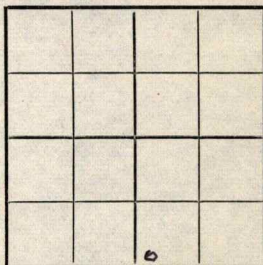

_____ Ft. from N. Line

330 Ft. from S. Line

_____ Ft. from E. Line

330 Ft. from W. Line

CARMi POOL

Location _____

Rig up _____

Drilling and Remarks:

Cor 4284
4" @ 4287
1000 acid
Sept 1943
Max 3000
40 2 1/2

RECORD

Cased _____ in., _____ ft.

Sand _____

Gas _____

Oil _____

Total Depth 4312

PRODUCTION

1st 24 hrs. Nat. _____

1st 24 hrs. after shot _____

Gas _____ Cu. Ft.

Dry Hole _____

Abandoned _____

Date

JUL 28 1943 19

S. J. LEWIS Scout