

KANSAS

Pratt


Section 31 Township 26 Range 12W

Well No. 10 Binger

Company Magnolia

Carmi Pool
NORTH

O.W.W.O.

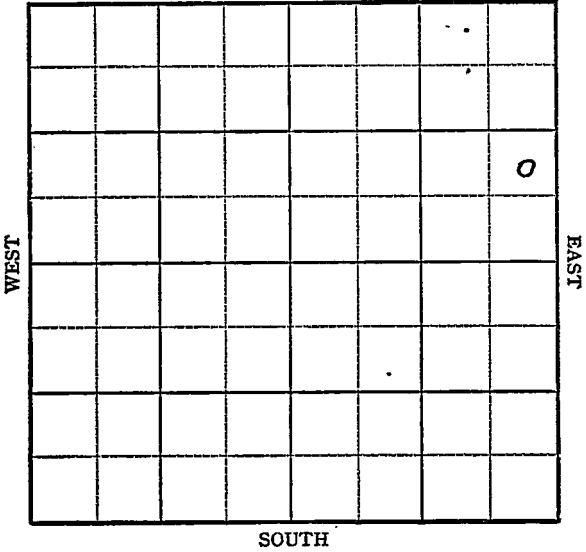

KANSAS Pratt

Sec. 31 Twp. 26 R. 12-W ✓

Well No. #10 Binger Farm

Magnolia

Carmi Pool

Company

O.W.W.O.

NORTH


 Ft. from N. Line

990 Ft. from S. Line

330 Ft. from E. Line

 Ft. from W. Line

NE SE NE

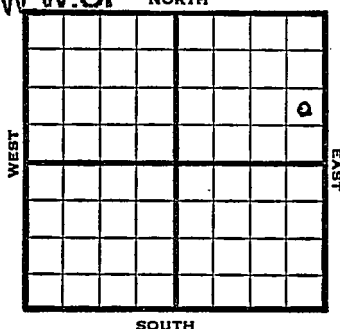

1948	Elev. 1912'	REPORT
11/3	Drlg 90'	
11/10	10" @ 650 Drlg 2185'	
11/16	Drlg. 3695'	
11/23	Miss 4090' Simp 4171' Drlg 4180'	
11/30	Arb. 4292'-94' TD 4294' 7" @ 4292'	
12/6	TD 4317 Swb 45 gal oil & 4 bbls W PH - 4 hrs.	
12/14	"	
12/22	"	
12/29	"	
1/5	Testing	
1/12	"	
1/19	"	
1/26	"	
2/2	"	
2/9	PB 1500 Whipstock Drlg. 1627'	
2/16	Drlg. 2000'	
2/23	TD 3390'	
3/2	Drlg. 4120'	

OVER

1949

3/8

Simpson 4173'

Arbuckle 4290'

TD 4292'

7" @ 4291'

3/16

TD 4299'

3/23

Pump 5 bbls oil PH 7 hrs.

3/30

Arb 4290'

7" @ 4297'

Pump 78 oil & 43 W Pot.

Gr. 42°

TD 4299'

COMPLETED

1950

3/15

Simp 4177'

Arb. 4292-4317 TD

7" @ 4291'

PB 4286'

115 shots

4208-30

Flowed 30 BOPH for 3 hrs

Flowed 6 BOPH for 4 hrs 1/8" choke

Est. 5,000 cu ft gas

Flow 12 BOPH Est. 70,000 cu ft gas

Gas oil Ratio 243/1

Flowed 148 BOPD 11/32" choke

3/22

Simp 4177'

Arb. 4292'

7" @ 4291'

TD 4317'

PB 4286'

Comp 211 BOPD

Comp

COMPLETED

Map No. _____ Sec. 31 Twp. 26 R. 12W

Well No. 10 Binger

Magnolia Company

FIRST REPORT Contractor

NE SE NE

SECTION PLAT

_____ Ft. from N. Line

990 Ft. from S. Line

330 Ft. from E. Line

_____ Ft. from W. Line

			o

Pratt County

Location _____

Rig up _____

Drilling and Remarks:

drlg. 90'

RECORD

Cased _____ in., _____ ft.

Sand _____

Gas _____

Oil _____

Total Depth _____

PRODUCTION

1st 24 hrs. Nat. _____

1st 24 hrs. after shot _____

Gas _____ Cu. Ft.

Dry Hole _____

Abandoned _____

Date

NOV 3 1948 19 S. J. LEWIS Scout

Map No. 47 Sec. 31 Twp. 26 R. 12W

Well No. 10 Binger

Magnolia

Company

COMPLETE

Contractor

NE SE NE

E11912
SECTION PLAT

			6

 Ft. from N. Line

990 Ft. from S. Line

330 Ft. from E. Line

 Ft. from W. Line

Pratt County

Location

Rig up

Drilling and Remarks:

CR X4290

7" @ 4290.

Run 78 oil + 42W
Bot.

42 2/3

RECORD

Cased in., ft.

Sand

Gas

Oil

Total Depth 4290

PRODUCTION

1st 24 hrs. Nat.

1st 24 hrs. after shot

Gas Cu. Ft.

Dry Hole

Abandoned

Date

MAR 30 1949

19

S. J. LEWIS

Scout

Map No. _____ Sec. 31 Twp. 26 R. 12WWell No. 10 BingerMagnolia**O.W.W.O.**

Company

Contractor

NE SE NE


E1. 1912

SECTION PLAT

_____ Ft. from N. Line

990 Ft. from S. Line330 Ft. from E. Line

_____ Ft. from W. Line

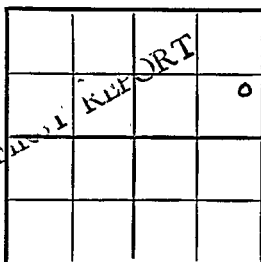

Pratt County

Location _____

Rig up _____

Drilling and Remarks:

Simp. 4177

Arb. 4292-4317

7" @ 4291

PB 4286

115 shots

4208-30

Flowed 30 BOPH
for 3 hrs.

(over)

RECORD

Cased _____ in., _____ ft.

Sand _____

Gas _____

Oil _____

Total Depth _____

PRODUCTION

1st 24 hrs. Nat. _____

1st 24 hrs. after shot _____

Gas _____ Cu. Ft.

Dry Hole _____

Abandoned _____

Date

MAR 15 1950 19**J. E. TYRA**

Scout

Flowed 6 BOPH for 4 hrs. $1\frac{1}{8}$ " choke.
Est. 5,000 cu. ft. gas

Flow 12 BOPH Est. 70,000 cu. ft. gas
Gas Oil Ratio 243/1

Flowed 148 BOPD $11\frac{1}{32}$ " choke

Scout Cards
Land Small Map
Land Wall Map
Tracings
France Map
Pierce Map
Misc.

APR 17 1950

Map No. _____ Sec. 31 Twp. 26 R. 12WWell No. 10 BingerMagnolia

Company

Contractor

NE SE NE

E1.1912

SECTION PLAT

			0
COMPLETE			

_____ Ft. from N. Line

990 Ft. from S. Line330 Ft. from E. Line

_____ Ft. from W. Line

Pratt County

Location _____

Rig up _____

Drilling and Remarks:

Simp 4177
arb 4292
7" @ 4291
T.D. 4317
PB 4286
Comp. 211 bpsd

RECORD

Cased _____ in., _____ ft.

Sand _____

Gas _____

Oil _____

Total Depth _____

PRODUCTION

1st 24 hrs. Nat. _____

1st 24 hrs. after shot _____

Gas _____ Cu. Ft.

Dry Hole _____

Abandoned _____

Date

MAR 22 1950

19

J. E. TYRA

Scout