
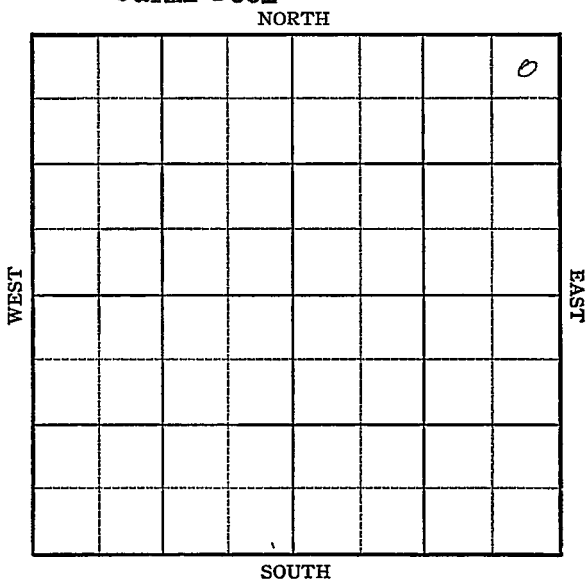


Section 31 Township 26 Range 12-W

Well No. #11 Binger

Company Magnolia
Carmi Pool

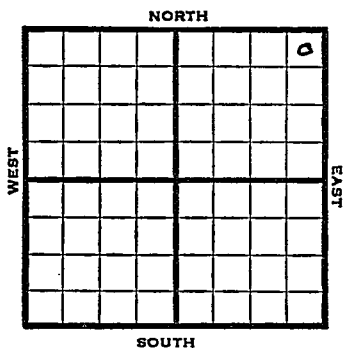

Sec. 31 Twp. 26 R. 12W ✓Well No. #11 Binger FarmMagnolia CompanyGarmi Pool Contractor330' Ft. from N. Line Ft. from S. Line330' Ft. from E. Line Ft. from W. Line~~NE NE NE~~

1949 Elev. 1914' REPORT

11/9 Location
11/16 8" @ 627'
Drlg 1850'
11/23 Drlg. 2620'
11/29 Lansing 3696'
Miss 4093'
Viola 4125'
Simpson 4165'
Arbuckle 4278-85'
TD 4285'
5" @ 4280'
12/7 TD 4293'
12/14 Arb 4278'
5" @ 4280'
Acid 500
Pump 210 oil Pot.
Gr. 40°
TD 4298'

COMPLETED**O.W.W.O.**

1955
12/21 OTD 4298'. GO to 4260' 36/4226-35
B/4½ GO 8½ BWPH 250 A S/2 B0
11 hr. Viso-frac. S/18 BOPH 5 hr.
Comp. 137 BOPD. TD 4298
~~XXXXXX~~ Simpson 4165'

FIRST REPORT**COMPLETED**

Map No. _____ Sec. 31 Twp. 26 R. 12W

Well No. 11 Binger

Magnolia Company

Contractor

NE/C

FIRST REPORT
SECTION PLAT

			o

330 Ft. from N. Line

Ft. from S. Line

330 Ft. from E. Line

Ft. from W. Line

Pratt County

Location X

Rig up

Drilling and Remarks:

RECORD

Cased _____ in., _____ ft.

Sand _____

Gas _____

Oil _____

Total Depth _____

PRODUCTION

1st 24 hrs. Nat. _____

1st 24 hrs. after shot _____

Gas _____ Cu. Ft.

Dry Hole _____

Abandoned _____

Date

NOV 9 1949 19

S. J. LEWIS Scout

Map No. _____ Sec. 31 Twp. 26 R. 12W

Well No. 11 Binger

Magnolia Company

COMPLETE

Contractor

NE/C

E1/19/4
SECTION PLAT

330 Ft. from N. Line

_____ Ft. from S. Line

330 Ft. from E. Line

_____ Ft. from W. Line

			6

Pratt County

Location _____

Rig up _____

Drilling and Remarks:

Cr Y4278
5" @ 4280
500 acid
Pump 210 oil
400 lb.

RECORD

Cased _____ in. _____ ft.

Sand _____

Gas _____

Oil _____

Total Depth 4278

PRODUCTION

1st 24 hrs. Nat. _____

1st 24 hrs. after shot _____

Gas _____ Cu. Ft.

Dry Hole _____

Abandoned _____

Date

DEC 14 1949

19

S. J. LEWIS

Scout

W.W.O.

OWWO

FORM 513 REV. SUNRAY

County Pratt Elev. _____
 Sec. 31 Twp. 26 Rge. 12W
 Company Magnolia Pet.
 Farm Name C. J. Binger No. 11

TOPS	DEPTH	LOG	DATUM
Anh.			
TP.			
H.			
Tr.			
Dg.			
Bl.			
L.			
K.C.			
B.K.C.			
Ce.			
C.			
M.			
M.			
K.			
Mz.			
Me.			
V.			
S.			
S.			
A.			
R.			
Pe.			
G.			
T.D.	<u>4298</u>		

Loc. in Sec. _____
NE NE NE
 Geol. _____
 Contr. _____
 Pool _____
Garmi

FIRST REPORT
 DEC 21 '55
 COMPLETE

Date Comm. OTD 4298 GO to 4260 36/ 4226-35
B/ 4 1/2 go 8 1/2 gwph 250 A S/ 2 bo
11 hr. viso-frac S/ 18 boph 5 hr.
Comp. 137 bopd