FORM 51


Pratt

KANSAS

Section 31 Township 26 Range 12W

Well No. 14 C. J. Binger

Company Magnolia Petr.

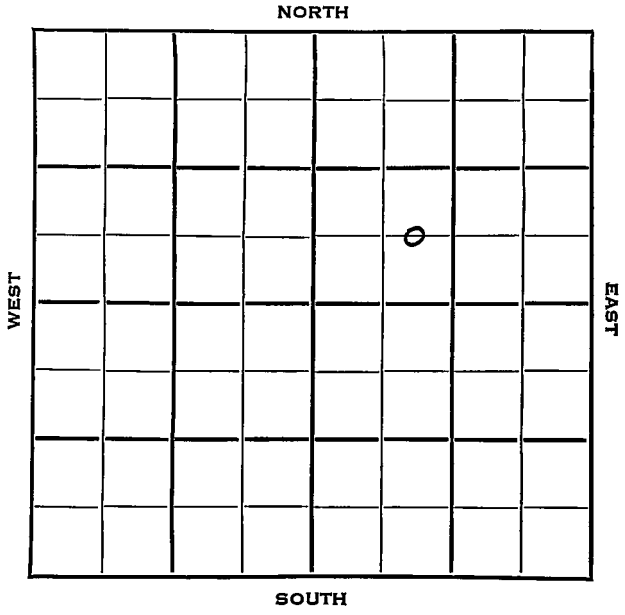

Pratt KANSAS

SEC.	TWP.	R.
31	26	12 W

WELL NO.

14 C. J. Binger FARM

COMPANY

Magnolia Pet.

CONTRACTOR

Iuka-Carmi Pool


_____ Ft. from N. Line

660 Ft. from S. Line

_____ Ft. from E. Line

990 Ft. from W. Line

C E L SW NE

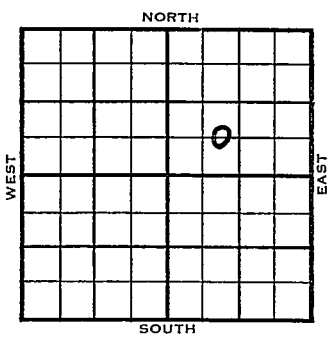

1953	ELEVATION 1912' REPORT
11/4	Location
11/11	8" @ 730' w/600 sks Drlg 1565'
11/18	Drlg 4044'
12/2	Spud 11-5-53 Oil well TD 4297 8" @ 730 Lans 3703 Miss 4068 Kh. 4130 Viola 4137 Simp 4176 Arb. 4292' TD 4295 5" @ 4293 DD 4297 6 GO 12 GWPH 5 hr. 250 A S/83 BO 22 BW 7 hr. P/90 BO 66 BW 12 hr. Comp. 64 BOPD 136 BW COMPLETED

DX-78

FORM 275 FOR SALE BY KANSAS BLUE PRINT CO.


County Pratt State Kansas

Sec. 31 (Blk. Twp.) 26 (Sur. Rge.) 12W Map No.

Operator Magnolia Pet.

Well No. 14 Farm C. J. Binger

Elev. Location C E L SW NE

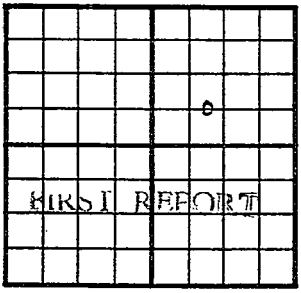

660 Ft. From S Line NE

990 Ft. From W Line Quarter

1st. Report NOV 4 1953

Completion

Remarks

Spudding Date

Drlg. Data Iuka-Carmi Pool

Location

J. G. McGEHEE

FORM 275 FOR SALE BY KANSAS BLUE PRINT CO.


County Pratt State Kansas

Sec. 31 (Blk. Twp.) 26 (Sur. Rge.) 12W Map No.

Operator Magnolia Pet.

Well No. 14 Farm C. J. Binger

Elev. 1912 Location C E L SW NE

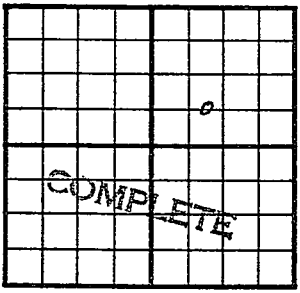

660 Ft. From S Line NE

990 Ft. From W Line Quarter

1st. Report

Completion DEC 2 1953

Remarks Iuka-Carmi Pool

Spudding Date 11-5-53

Drlg. Data Oil well TD 4297

8" @ 730 Lans. 3703 Miss. 4068

Kh. 4130 Viola 4137 Simp. 4176

Arb. 4292 TD 4295 5" @ 4293 DD 4297

6 go 12 gwph 5 hr. 250 A

S/ 83 bo 22 bw 7 hr. P/ 90 bo 66 bw

12 hr. Comp. 64 bopd 136 bw

J. G. McGEHEE