

HOT FILE Pratt **KANSAS**

SEC. 26 TWP. 26 R. 13 W ✓

WELL NO. # 2 Hoener FARM

COMPANY H. L. Moore

CONTRACTOR Reserve Drlg.


Inka-Carmi Pool

330 Ft. from N. Line

Ft. from S. Line

990 Ft. from E. Line

Ft. from W. Line

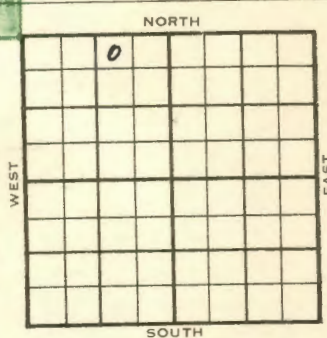

NW NE NW

MCPC has SE of 22

ELEVATION REPORT

1954 1943'

2/3 Spud 2-27-54

8" @ 540' Any 800'

Drlg. 1450'

3/11 Drlg. 4026' (Ltr-McGehee)

3/25 Br. lime 3732' Lans 3755' B KC 4075'

Miss 4170'

DST 4173-93, open 1 hr, rec 30' mud 0#

Kh. 4190' Viola 4209'

DST 4203-50, open 1 hr rec 30' SO & GCM

120' HO & GCM, 120' MCO, 60' clean oil,

1110# Simp. 4254'

DST 4245-95, open 1 hr, rec 3950' gas,

15' O & GCM, 60' MCO, 8' mud, 1155#

Arb. 4351'

DST 4353-71' open 1 hr, gas in 38 min,

rec 2630' oil. 1382#

TD 4371' (Ltr-McGehee)

3/31 5" @ 4353'

4/7 CO 4371'

4/21 Spud 2-27-54

Oil Well

TD 4371'

8" @ 540'

DX-78


OVER

FORM 51 Pratt **KANSAS**

Section 26 Township 26 Range 13W

Well No. 2 Hoener

Company H. L. Moore

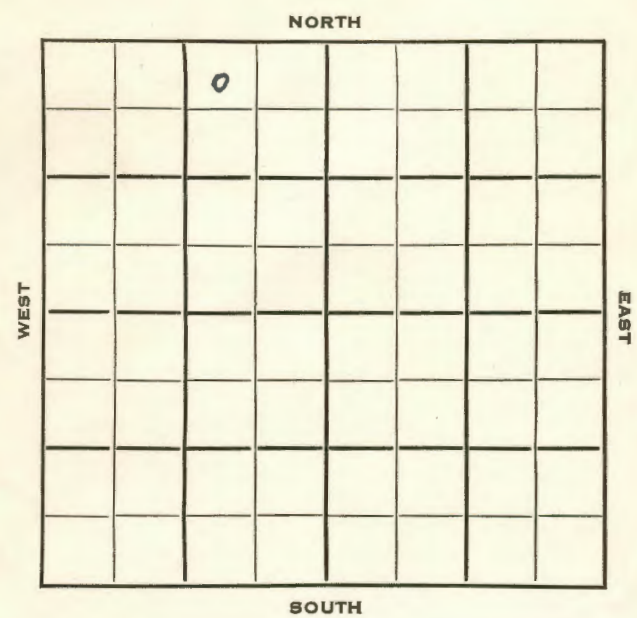

County Pratt State Kansas
 Sec. 26 (Blk. Twp.) 26 (Sur. Rge.) 1SW Map No.
 Operator H. L. Moore
 Well No. 2 Farm Hoener
 Elev. _____ Location NW NE NW

0				

330 Ft. From N Line NW
990 Ft. From E Line Quarter
 Ist. Report MAR 3 1954
 Completion _____
 Remarks MCPC has SE of 22
Reserve Drlg. - Contr.
 Spudding Date 2-27-54
 Drlg. Data Iuka-Carmi Pool
8" @ 540 Anhy 800 drlg. 1450

J. G. McGEHEE

County Pratt State Kansas
 Sec. 26 (Blk. Twp.) 26 (Sur. Rge.) 1SW Map No.
 Operator H. L. Moore
 Well No. 2 Farm Hoener
 Elev. 1943 Location NW NE NW

0				

330 Ft. From N Line NW
990 Ft. From E Line Quarter
 Ist. Report _____
 Completion APR 21 1954
 Remarks Iuka-Carmi Pool
Reserve Drlg. - Contr.
 Spudding Date 2-27-54
 Drlg. Data Oil well TD 4371
8" @ 540 Anhy 800 Br. lime 3732
Lans. 3755 B KC 4075 Miss. 4170
DST 4173-93 open 1 hr. Rec. 30' mud
O# Kh. 4190 Viola 4209 DST 4203-50
open 1 hr. Rec. 30' so & gcm 120' ho &
gcm 120' mco 60' clean oil 1110#
Simp. 4254 DST 4245-95 open 1 hr.
Rec. 3950' gas 15' o & gcm 60' mco &
mud 1155# Arb. 4351 DST 4353-71
open 1 hr. gas in 38 min. Rec. 2630'
oil 1380# 5" @ 4353 CO to 4371
Comp. 302 bopd

J. G. McGEHEE

1954

Information brought forward.

4/21

Anhy 800', Br. Lime 3732', Lans 3755'

B KC 4075' Miss 4170',

DST 4173'-93' opn 1 hr, rec 30' Mud

O# Kh. 4190', Viola 4209'

DST 4203'-50' opn 1 hr, rec 30' so &
gcm, 120' ho & gc 120' mco, 60' clean
oil, 1110#

Simp 4254',

DST 4245'-95' opn 1 hr, rec 3950' gas,
15' o & gcm 60'mco & mud 1155#

Arb 4351'

DST 4353'-71' opn 1 hr, gas in 38 min
rec 2630' oil 1380#

5" @ 4353'

CO to 4371'

Comp 302 bopd

COMPLETED