

HOT FILE

Pratt

KANSAS

SEC. 27 TWP. 26 R. 13 W

WELL NO. # 1 W. B. Ripp FARM

COMPANY A. G. Hill

CONTRACTOR Reserve Drlg. Semi Wildcat


330 Ft. from N. Line

Ft. from S. Line

330 Ft. from E. Line

Ft. from W. Line

NE NE NW

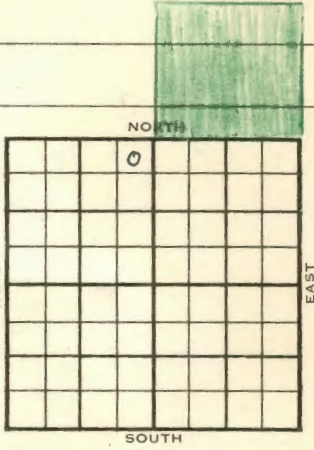

MCPC has SE/4 of 22

1954	ELEVATION	REPORT
	1935	

6/2 MIR
6/10 Spud 6-2-54
8" @ 521 w/250 sax.
Drlg. 3200' (Ltr-McGehee)

6/25 D & A. TD 4475' " "

6/23 Spudding 6-2-54
D&A
TD 4475
8" @ 521
Heeb 3603 Doug. 3625 Lans. 3794
DST 3976-4007 open 1 hr. Rec. 50' socm
1050# ~~2mg~~
Cong. 4220 Miss. 4250
DST 4250-70 open 1 hr. Rec 1440'
gas 50' . & gcm
Kh. 4279 Viola 4293
DST 4292-4330 open 1 hr
Rec. 35' mud 97#
Simp 4337
DST 4335-60 open 1 hr. Rec. 70' mud
30#
Arb 4428
TD 4475
DST 4067-81 open 1½ hr. Rec. 180' sw
1180#
D&A

ABANDONED

DX-78

DX 78-1

Pratt KANSAS

Section 27 Township 26 Range 13W

Well No. 1 W. B. Ripp

Company A. G. Hill

