



Section 28 Township 26 Range 13W
 Well No. #3 Frisby (Frisbie)
 Company Sunray

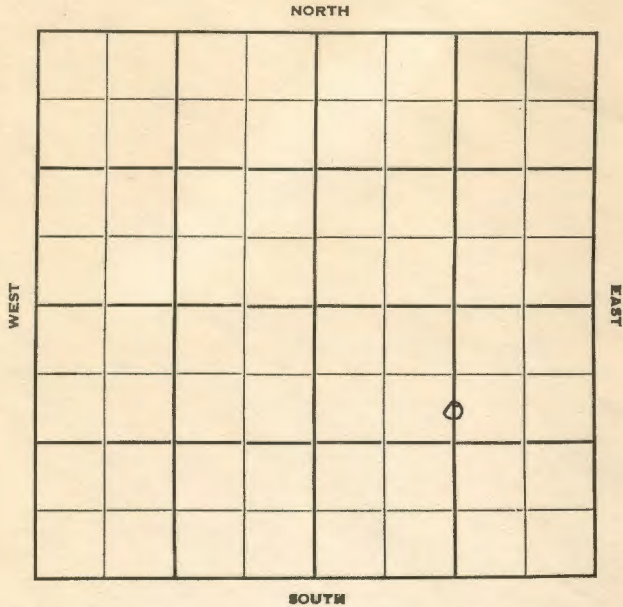

Sec. 28 Twp. 26 R. 13W
 Well No. #3 Frisby Farm
 Company Sunray Contractor

Chance
990' Ft. from N. Line
 _____ Ft. from S. Line
1320' Ft. from E. Line
 _____ Ft. from W. Line

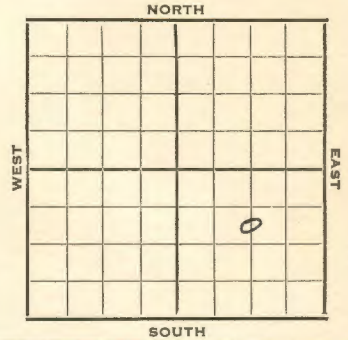

C S/2 N/2 SE

1952 **Elev. 1948'** REPORT

5/7 Location
 5/14 "
 5/21 13" @ 267'
 8" @ 1161'
 5/28 Drlg. 3135'
 6/11 RTD 4510' 5" @ 4509' DP
 6/18 CO 4465' 19/4332-38 16 gal WPH
 Sq off. 15/4315-20 2 gal WPH
 set plug @ 4305' 46/4269-84
 8 gal OPH plus some gas 500 A
 1 BOPH for 8 hrs. Hyd.
 6/25 F 7 Boph for 6 hrs. went dead F 16
 Bo 3 hrs. went dead. POP
 7/2 NR
 7/9 Oil Well TD 4510 13" @ 267
 8" @ 1161 **KC 3788**
Miss 4204
 DST 4226-34 opn 1 hr.
 Rec. 30' mud 660' gas 525#
Viola 4267
 DST 4269-85 opn 1 hr. Rec. 3700
 gassy oil 1080# **Simp 4373**
Arb. 4457 TD 4510 5" @ 4509
 CO to 4465 19/4332-38 16 to 18
 gwph 15/4315-20 B/2 gswph
 SP 4305 46/4269-84 8 goph & some
 gas 500 A 1 boph Hydro
 F/7 boph F/16 bo 3 hr.
 Comp. 266 boyl **COMPLETED**

