


Section 28 Township 26 Range 13W

Well No. #3 Reed

Company Rine Drlg.

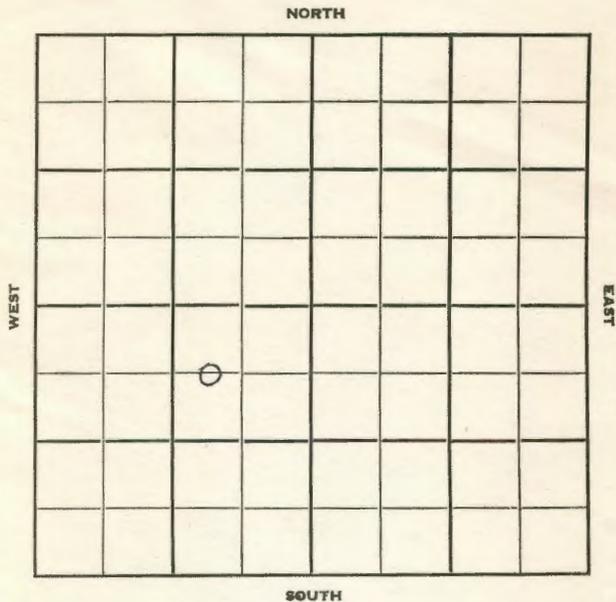

Sec. 28 Twp. 26 R. 13W

Well No. #3 Reed Farm

Company Rine Drlg.

Contractor Rine


660 Chance  
Ft. from N. Line

\_\_\_\_\_ Ft. from S. Line

990 Ft. from E. Line

\_\_\_\_\_ Ft. from W. Line

W/2 NE SW

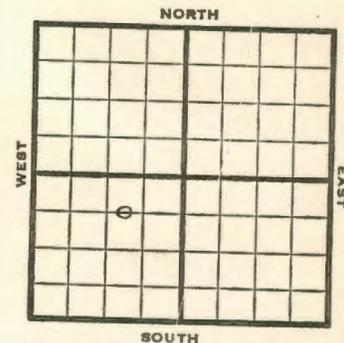

1951 **Elev. 1946'** REPORT

10/31 Spud 10-20-51  
8" @ 840'  
Heeb 3606' Lans. 3801'  
Br. L. 3773' Miss Ch. 4250'  
DST 4250-70 1 hr. 2000'  
Gassy oil

12/5 Spud 10-20-51  
Oil well TD 4623' 8" @ 840'  
Heeb 3606' Br. line 3773' Lans 380'  
Miss 4250'  
DST 4250-70 open 1 hr. rec 2000' gass oil.  
Kh. 4321' Viola 4357'  
DST 4356-78 open 45 min. rec 20' mud & SSO  
Simp. 4440' Arb. 4514'  
TD 4623' 5" @ 4616' CO to 4585'  
64/4302-14 8 GO 2 GWPB 500 A  
3/4 BOPH Hydro. F/18 BOPH  
Comp. BHB 698 BOPD

**COMPLETED**

County **Pratt** State **Kansas**  
 Sec. **28** (Blk. **26**) (Sur. **13W**) Map No.  
 Operator **Rine Drlg.**  
 Well No. **3** Farm **Reed**  
 Elev. **1946** Location **C W L NE SW**


**660** Ft. From **N** Line **SW**  
**990** Ft. From **E** Line **Quarter**  
 Ist. Report  
 Completion **DEC 5 1951**  
 Remarks **Chance Pool**  
**Rine Drlg. - Contr.**  
 Spudding Date **10-20-51**

Drlg. Data **Oil well TD 4623**  
**8" @ 840 Heeb. 3606 Br. line 3773**  
**Lans. 3801 Miss. 4250 DST 4250-70**  
**open 1 hr. Rec. 2000' gassy oil**  
**Kh. 4321 Viola 4357 DST 4356-78**  
**open 45 min. Rec. 20' mud & SSO**  
**Simp. 4440 Arb. 4514 TD 4623 5" @ 4618**  
**CO to 4585 64/ 4302-14 8 go 2 gwph**  
**500 A 3/4 boph Hydro. F/ 18 boph**  
**Comp. HHB 698 bopd**

J. E. TYRA

County **Pratt** State **Kansas**  
 Sec. **28** (Blk. **26**) (Sur. **13W**) Map No.  
 Operator **Rine Drlg.**  
 Well No. **3** Farm **Reed**  
 Elev. Location **W/2 NE SW**


**660** Ft. From **N** Line **SW**  
**990** Ft. From **E** Line **Quarter**  
 Ist. Report **OCT 31 1951**  
 Completion  
 Remarks  
**Rine - Contr.**  
 Spudding Date **10-20-51**

Drlg. Data **Chance**  
**8" @ 840' Heeb 3606 Br. L 3773 Lans 3801**  
**Miss Ch 4250 DST 4250-70 1 hr. 2000'**  
**Gossey oil**

J. E. TYRA