



Sec. 28 Twp. 26 R. 13W

Well No. #4 Reed Farm

Rine-Roberts-Murphy Company

Rine Drlg. Contractor

Chance Pool


990 Ft. from N. Line

\_\_\_\_\_ Ft. from S. Line

\_\_\_\_\_ Ft. from E. Line

990 Ft. from W. Line

SE NW SW

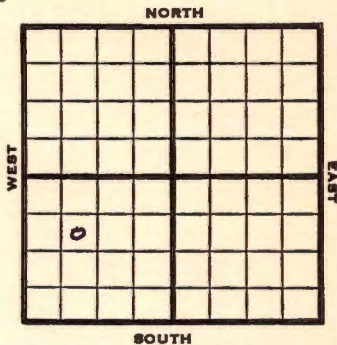

1953 **Elev. 1952'** REPORT

7/1 Spud 6-28-53  
8" @ 862'  
WOC.

7/8 **Anhy 865** Fish @ 3641'

7/22 Whipstock  
Drlg 3195'

7/29 **Heeb 3616** **Br li 3782** **Lans 3802**  
**B KC 4128** **Miss 4262**  
DST 4260-4300, 1 hr, 35' M 45# 20"  
DST 4325-53 ?

8/5 Spud 6-28-53 D & A TD 4458  
8" @ 862 **Anhy 865** **Heeb 3616**  
**Br line 3782** **Lans 3802** **B KC 4128**  
**Miss 4262**  
DST 4260-4300 open 1 hr rec 35' mud  
45#  
DST 4325-53 open 1/2 hr rec 15' mud 30#  
DST 4388-4422 open 1 hr rec 95' mud  
1230# **Simp 4439** TD 4458  
D & A

**ABANDONED**



