


Section 28 Township 26 Range 13W

Well No. #2 Strait

Company Lion Oil

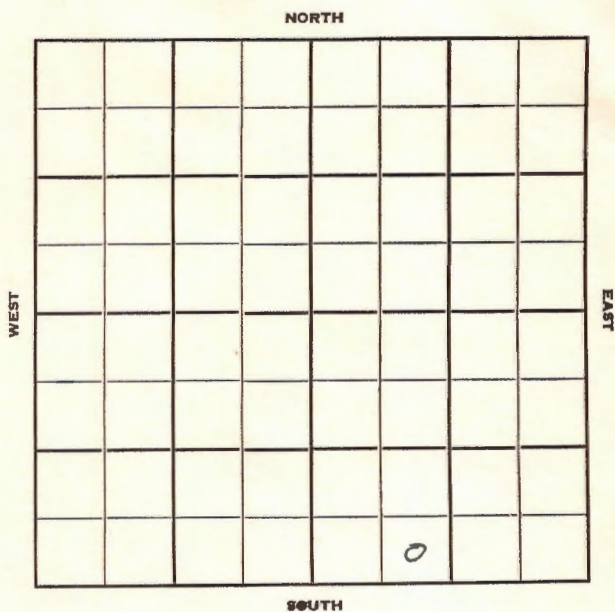

Sec. 28 Twp. 26 R. 13W ✓

Well No. #2 Strait Farm

Lion Oil Company

Rine Drlg. - Contr. Contractor

Chance Pool


Ft. from N. Line

330' Ft. from S. Line

Ft. from E. Line

990' Ft. from W. Line

SE SW SE

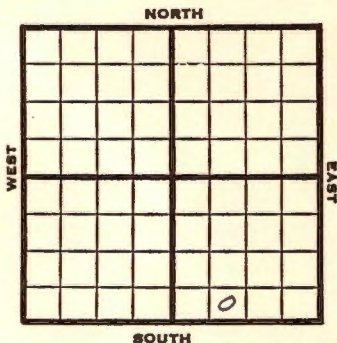

1951

Elev. 1949'

REPORT

2/7

RUR

3/7

Spud 2-7-51

Oil well

TD 4415

8" @ 835

Br. lime 3753 Lans. 3766 Viola 4216

DST 4281-4300 open $\frac{1}{2}$ hr. Rec. 360'

oil & mud

Simp. sh 4312 Simp. sd 4314

Arb. 4410-15 TD

500 A S/ 4 boph 1000 A S/ 5 boph

2000 A no inc.

Comp. 60 bopd

COMPLETED

