

Pratt

KANSAS


O.W.P.B.

Section 28 Township 26 Range 13WWell No. #3 StraitCompany Lion Oil

NORTH

WEST

EAST

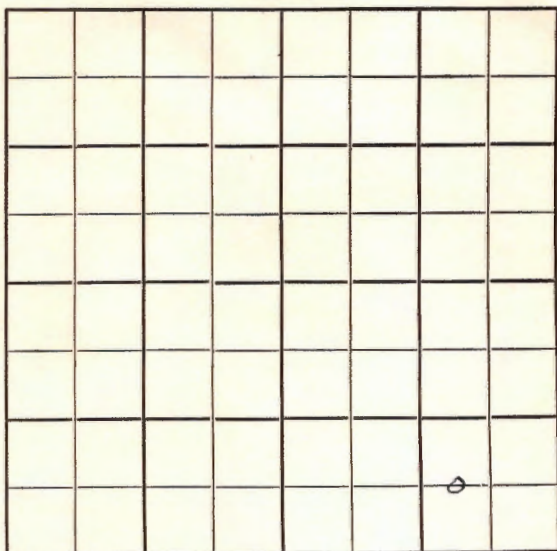

SOUTH

Pratt

KANSAS O.W.P.B.

Sec. 28 Twp. 26 R. 13 W

Well No. # 3 Strait Farm

Lion Oil Company

Rine Drlg. Contractor

Chance Pool


Ft. from N. Line

660 Ft. from S. Line

990 Ft. from E. Line

Ft. from W. Line

C W L S E S E

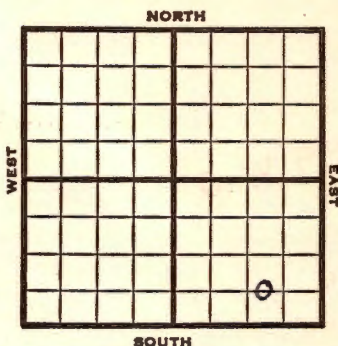

1951

Elev. 1950'

REPORT

3/7

Spud 3-2-51
8" @ 830
Drilling 2000'

4/4

Spud 3-2-51
Oil Well TD 4427
8" @ 830
Br Line 3750 Lans. 3768
DST 4278-4310 opn 1/2 hr
Rec. 90' hocm
630' oil & mud
Simp sh 4320 Simp. sd 4328
DST 4328-50 opn 1/2 hr
Rec. 210' oil & mud 180' wtr
Arb. 4418-23
5" @ 4422 TD 4427
SSO
1000 A S/11 boph
Comp. 100 bond

O. W. P. B.

COMPLETED

1952

4/23

Viola 4275 Arb. 4418 OTD 4427
RU to test Viola

4/30


DB 4315' 184/4278-4310' S/2 1/2 BOPH
for 11 hrs. plus trace wtr.
1000 A S/5 BOPH for 18 hrs 4% wtr.
POP

OVER

1952

5/7 Oil Well TD 4427
Viola 4275 Arb. 4418
OTD 4427 PB 4315
184/ 4278-4310 S/ $2\frac{1}{2}$ boph
1000 A S/ 5 boph 4% wtr.
Comp. 97 bopd

COMPLETED

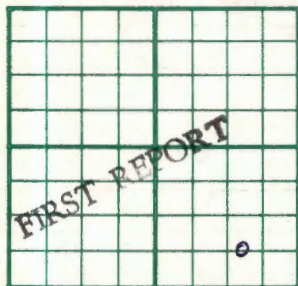County **Pratt** State **Kansas**Sec. **28** (Blk.) **26** (Sur.) **13W** Map No.Operator **Lion Oil**Well No. **3** Farm **Strait**Elev. **1950** Location **C W L SE SE****660** Ft. From **S** Line **SE****990** Ft. From **E** Line **Quarter**1st. Report **MAR 7 1951**

Completion

Remarks

Rine Drlg. - Contr.Spudding Date **3-2-51**Drlg. Data **Chance Pool****8" @ 830 drlg. 2000**

J. E. TYR


County Pratt State KansasSec. 28 (Blk.
Twp.) 26 (Sur.
Rge.) 13W Map No.Operator Lion OilWell No. 3 Farm StraitElev. 1950 Location C W L SE SE660 Ft. From S Line SE990 Ft. From E Line Quarter1st. ReportCompletion APR 4 1951Remarks Chance PoolRine Drlg. - Contr.Spudding Date 3-2-51Drlg. Data Oil well TD 44278" @ 830 Br. lime 3750 Lans. 3768DST 4278-4310 open $\frac{1}{2}$ hr. Rec. 90' hoom630' oil & mud Simp. sh. 4320Simp. sd. 4328 DST 4328-50 open $\frac{1}{2}$ hr.Rec. 210' oil & mud 180' waterArb. 4418-23 5" @ 4422 TD 4427 SSO1000 A S/ 11 boph Comp. 100 bopd

RU to test Viola

J. G. McGEHEE

O. W. P. B.

County Pratt State Kansas
 Sec. 28 (Blk.) 26 (Sur.) 13W Map No.
 Operator Lion Oil
 Well No. 3 Farm Strait
 Elev. 1950 Location C W L S E S E

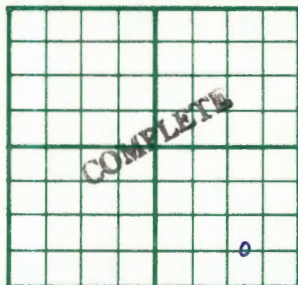

660 Ft. From S Line SE
990 Ft. From E Line Quarter

1st. Report

Completion MAY 7 1952Remarks OWPB

O. W. P. B.

Spudding Date

Drig. Data Oil well TD 4427Viola 4275 Arb. 4418 OTD 4427PB 4315 184/ 4278-4310 S/ 2½ boph1000 A S/ 5 boph 4% waterComp. 97 bopd

J. G. McGEHEE