


Section 28 Township 26 Range 13 W

Well No. # 5 Strait

Company Lion Oil

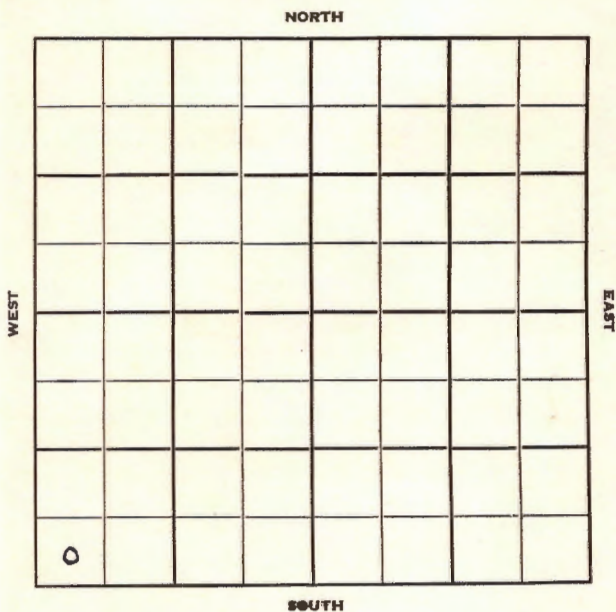

Pratt

KANSAS

Sec. 28 Twp. 26 R. 13W ✓

Well No. #5 Strait Farm

Lion Oil Company

Contractor

Chance Pool


 Ft. from N. Line

330' Ft. from S. Line

 Ft. from E. Line

330' Ft. from W. Line

SW SW SW

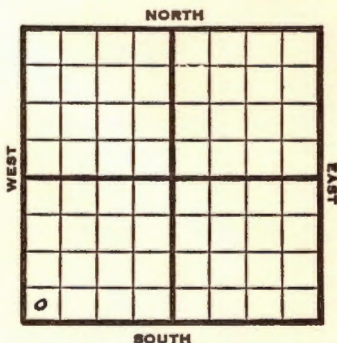

1951

Elev. 1955'

R E P O R T

5/23

Location

6/20

Spud 5-25-51 Oil well TD 4282'
 9" @ 842 Heeb 3631' Br. line 3789'
 KC 3806' Miss 4265-72 5" @ 4267'
 TD 4282' B/1/2 BOPH Hydrofrac
 F/8 BOPH
 Comp. 100 BOPD

COMPLETED

County **Pratt** State **Kansas**Sec. **28** (Blk.) **28** (Sur.) **13W** Map No.Operator **Lion Oil**Well No. **5** Farm **Strait**Elev. Location **SW SW SW**

0									

330 Ft. From **8** Line **SW****330** Ft. From **W** Line Quarter1st. Report **MAY 23 1951**

Completion

Remarks

Spudding Date

Drig. Data **Chance Pool****Location**

County Pratt State KansasSec. 28 (Blk.
Twp.) 26 (Sur.
Rge.) 13W Map No.Operator Lion OilWell No. 5 Farm StraitElev. 1955 Location SW SW SW

0					

330 Ft. From S Line SW330 Ft. From W Line Quarter1st. Report Completion JUN 24 1951Remarks Chance PoolSpudding Date 5-25-51Drilg. Data Oil well TD 42829" @ 842 Heeb. 3631 Br. lime 3789KC 3806 Miss. 4265-72 5" @ 4267TD 4282 B/ $\frac{1}{2}$ boph HydrofracF/ 8 boph Comp. 100 bopd

J. E. TYRA