

Pratt

KANSAS
13W

Section 28 Township 26 Range 13W

Well No. #6 Strait

Company Lion Oil

NORTH

WEST

EAST

SOUTH

0

Pratt

KANSAS

Sec. 28 Twp. 26 R. 13 W

Well No. # 6 Strait Farm

Lion Oil Company

Contractor

Chance Pool

Ft. from N. Line

330


Ft. from S. Line

Ft. from E. Line

330

Ft. from W. Line

SW SW SE

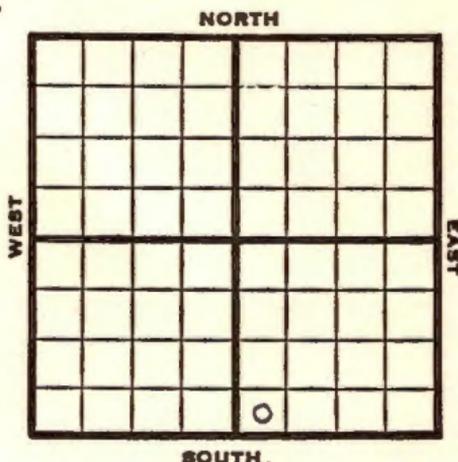

1951

Elev. 1949'

REPORT

6/13

Spud 6-9-51
12" @ 910

7/11

Spud 6-9-51 Oil well TD 4417'
9" @ 910 Br. line 3744' Lans 3759'
Simp. 4322'
DST 4320-45 open 45 min. rec 40' SOCM
Arb. 4414-17' TD 5" @ 4415'
72/4327-40 water & SSO SP 4308'
72/4292-4300 S/9 BOPH Hydrofrac
S/5 1/2 BOPH
Comp. 50 BOPD

COMPLETED

