


Section 29 Township 26 Range 13W
 Well No. 2 Mowbray
 Company H. L. Moore

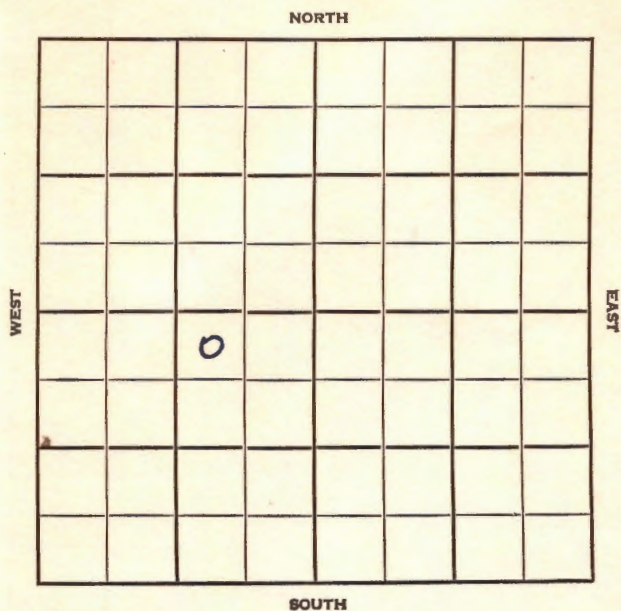

Pratt

KANSAS

SEC.	TWP.	R.
29	26	13 W

WELL NO.

2 Mowbray

FARM

COMPANY

H. L. Moore

CONTRACTOR

Reserve Drlg.

NW Chance Pool


330 Ft. from N. Line

Ft. from S. Line

990 Ft. from E. Line


Ft. from W. Line

NW NE SW

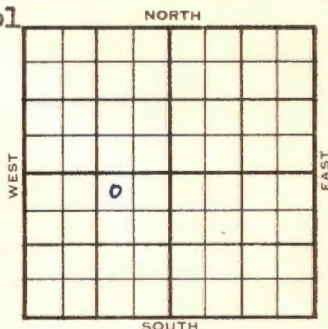

	ELEVATION	REPORT
1954	1947'	
7/14	Spud 7-12-54 8" @ 529 WOC	
9/1	Spud 7-12-54 - Oil Well TD 4470' 8" @ 529' Br. Lime 3782', Lans 3811', Miss 4255' DST 4253-82', opn 1 hr., rec. 30' mud, 85# Kh. 4277', Viola 4342', Simp. 4424' DST 4420-23', opn 1½ hrs., rec. 2420' gas, 150' O&GCM, 275# DST 4444-70', opn 1 hr., rec. 120' mud, 1000# TD 4470' 5" @ 4469' 48/4430-37', Sd-oil-frac P/72 BOPD P/76 bopd P/77 bopd Comp. 80 bopd 40% wtr.	

COMPLETED

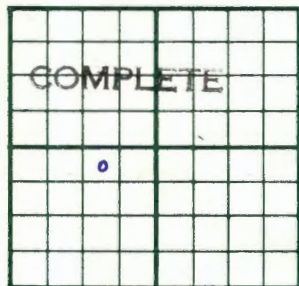County Pratt State KansasSec. 29 (Blk.
Twp.) 26 (Sur.
Rge.) 13W Map No.Operator H. L. MooreWell No. 2 Farm MowbrayElev. 1947 Location NW NE SW330 Ft. From N Line SW990 Ft. From E Line Quarter

1st. Report

Completion SEP 1 1954Remarks NW Chance PoolReserve Drlg. - Contr.Spudding Date 7-12-54Drlg. Data Oil well TD 44708" @ 529 Br. lime 3782 Lans. 3811Miss. 4255 DST 4253-82 open 1 hr.Rec. 30' mud 85# Kh. 4277 Viola 4342Simp. 4424 DST 4420-23 open 1½ hr.Rec. 2420' gas 150' o & gcm 275#DST 4444-70 open 1 hr. Rec. 120' mud1000# TD 4470 5" @ 4469 48/ 4430-37sd-oil-frac P/ 72 bopd P/ 76 bopdP/ 77 bopd Comp. 80 bopd 40% wtr.

FABEN GILSTRAP

J. G. McGEHEE