


Section 32 Township 26 Range 13-W

Well No. #2 Chance

Company Texas

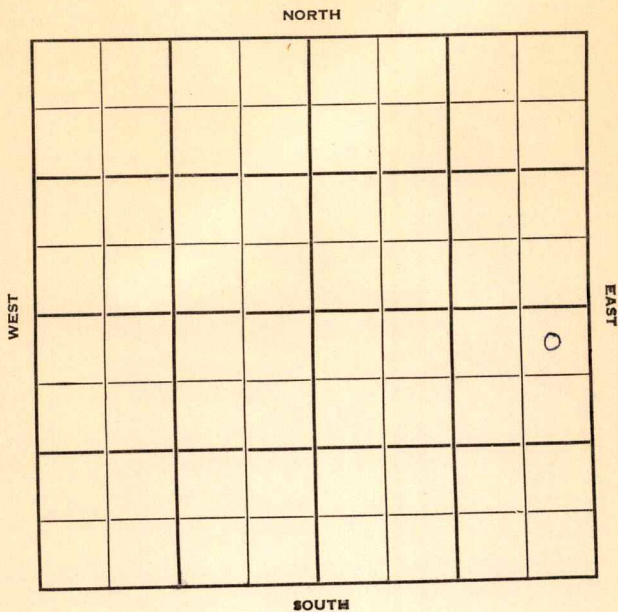

KANSAS

Pratt

Sec. 32 Twp. 26 R. 13-W

Well No. #2 Chance Farm

Texas Company

Stickle Drlg. - Contr. Contractor

Chance Pool


330 Ft. from N. Line

Ft. from S. Line

330 Ft. from E. Line

Ft. from W. Line

NE NE SE

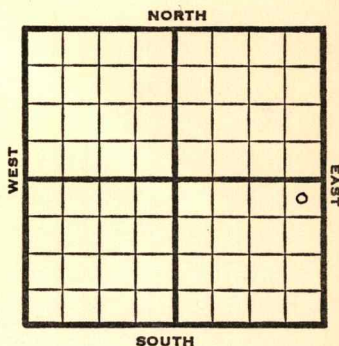

1950

Elev. 1964' REPORT

8/2

Spud 7-28-50

10" @ 853

WOC

10/4

Spud 7-28-50

Oil Well TD 4444'

10" @ 853' Anhy 845' Heeb. 3630'

Br Line 3773' Lans. 3809'

DST 3955-68 opn $\frac{1}{2}$ hr. Rec. 400' oil

20' OCM

Cong. 4147' Kinderhook 4232'

Viola 4255' Simp Sh 4344'

Simp sd 4349 SSO 4349-52

Cored 4352-62 Rec. sd & sh

Arb. 4427

7" @ 4430' TD 4433' S/28 GO 22 GWPH


500 A S/8 BO 54 BW 4 hr.

B 30 GO 10GWPH TD 4444'

500 A S/38.6 BO 16 BW 8 hr.

Comp. 35 BOPD

COMPLETED

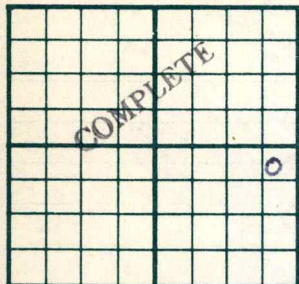County Pratt State KansasSec. 32 (Blk.) 26 (Sur.) 13W Map No.Operator TexasWell No. 2 Farm ChanceElev. 1964 Location NE NE SE330 Ft. From N Line SE330 Ft. From E Line Quarter

1st. Report

Completion OCT 4 1950Remarks Chance PoolStickle Drlg. - Contr.Spudding Date 7-28-50Drlg. Data Oil well TD 444410" @ 853 Anhy 845 Heeb. 3630Br. lime 3773 Lans. 3809 DST 3955-68open $\frac{1}{2}$ hr. Rec. 400' oil 20' ocmCong. 4147 Kinderhook 4232 Viola 4255Simp. sh. 4344 Simp. sd. 4349 SSO 4349-52Cored 4352-62 Rec. sd & sh. Arb. 44277" @ 4430 TD 4433 S/ 28 go 22 gwph500 A S/ 8 bo 54 bw 4 hr.B/ 30 go 10 gwph TD 4444 500 AS/ 38.6 bo 16 bw 8 hr.Comp. 35 bopd

J. E. TYRA

Kansas

Map No. _____ Sec. 32 Twp. 26 R. 13WWell No. 2 ChanceTexas

Company _____

Contractor _____

NE NE SE

SECTION PLAT

330 Ft. from N. Line

_____ Ft. from S. Line

330 Ft. from E. Line

_____ Ft. from W. Line

Pratt County

Location _____

Rig up _____

Drilling and Remarks:

Spud 7-28-50

10" @ 853

WOC

RECORD

Cased _____ in., _____ ft.

Sand _____

Gas _____

Oil _____

Total Depth _____

PRODUCTION

1st 24 hrs. Nat. _____

1st 24 hrs. after shot _____

Gas _____ Cu. Ft.

Dry Hole _____

Abandoned _____

Date

AUG 2 1950 19J. E. TYRA

Scout