


Section 32 Township 26 Range 13 W

Well No. # 4 Chance

Company Texas

NORTH

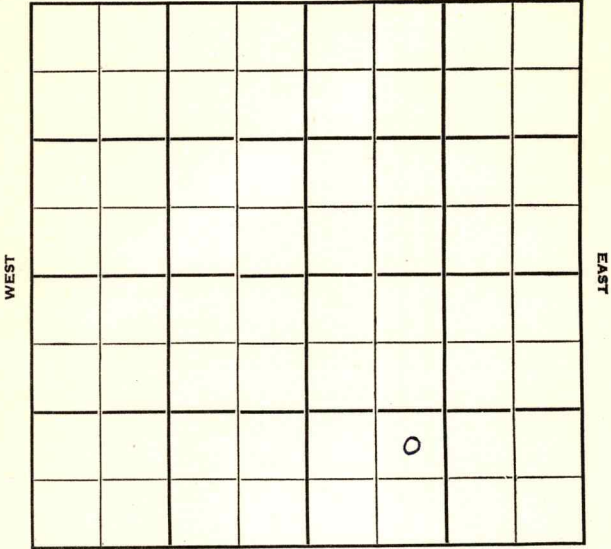

SOUTH

Sec. 32 Twp. 26 R. 13W

Well No. #4 Chance Farm \_\_\_\_\_

Texas \_\_\_\_\_ Company \_\_\_\_\_

Contractor \_\_\_\_\_

Chance Pool


\_\_\_\_\_ Ft. from N. Line

990' Ft. from S. Line

\_\_\_\_\_ Ft. from E. Line

990' Ft. from W. Line

NE SW SE

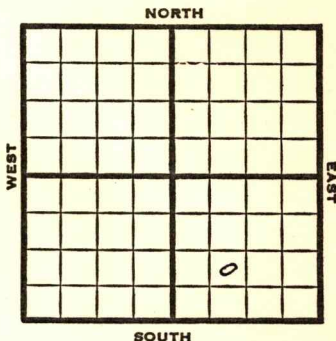

1951

**Elev. 1967'**

REPORT

5/23

Location

7/11

Spud 6-2-51 Oil well TD 4469'  
 10" @ 843 Heeb 3639' Br. line 3781'  
**Lans. 3807'**  
 DST 3858-76 open 45 min. rec 240' wtr.  
 DST 4005-14' open 1 hr. rec 65' oil  
 & GCM  
**KC 4232' Viola 4258' Simp. 4349'**  
**Arb. 4436'**  
 DDST 4459-69 open 1 hr. rec 50' HOCM  
 400' oil TD 4469' 7" @ 4459'  
 S/81 BO 12 hr.  
 Comp. 83 BOPD 4 BW

**COMPLETED**



