

Section 32 Township 26 Range 13WWell No. 5 ChanceCompany Texas Co.

NORTH

					0		

WEST

EAST

SOUTH

Pratt

KANSAS

Sec. 32 Twp. 26 R. 13W ✓

Well No. #5 Chance Farm

Texas Co. Company

Contractor

Chance Pool


330' Ft. from N. Line

Ft. from S. Line

Ft. from E. Line

990' Ft. from W. Line

NE NW SE

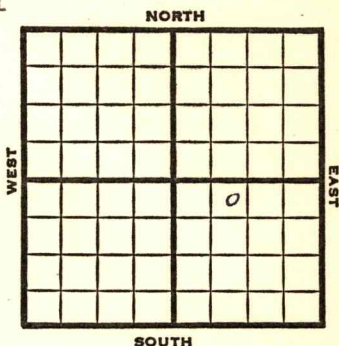

1951

Elev. 1960' REPORT

7/25

Location

9/19

Spd 7-29-51

Oil Well TD 4330

8" @ 852

Heeb. 3634

Br lime 3790

KC 3815

Miss 4266

DST 4266-86 opn 1 hr, gas in 1 hr.

Rec. 250' mud 640' ho & gcm

65' oil

Kh 4326

TD 4330

5" @ 4329

40/4300-10 B/64 go SSW 1 hr

40/4280-90 S/1 bo 14 gw 1 hr

Hydrofrac F/23 boph 5 hr.

F/93 bo 7 hr P & F/100 bopd

Comp. 185 bopd 2% wtr.

COMPLETED

County **Pratt** State **Kansas**

Sec. **32** (Blk. Twp.) **26** (Sur. Rge.) **13W** Map No.

Operator Texas Co.

Well No. **5** Farm **Chance**

Elev.	Location	NE	NW	SE

FIRST REPORT

330 Ft. From N Line SE

990 Ft. From W Line Quarter

1st. Report JUL 29 1951

Completion

Remarks


Spudding Date _____

Drlg. Data	Chance Pool

Location

J. E. TYRA

County Pratt State Kansas
 Sec. 32 (Blk. 2 6) (Sur. 13W) Map No. 13W
 Operator Texas Company
 Well No. 5 Farm Chance
 Elev. 1960 Location NE NW SE

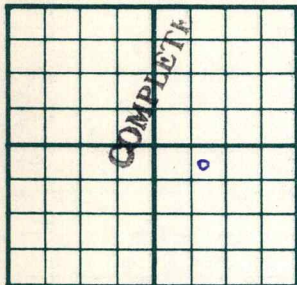

330 Ft. From N Line SE
990 Ft. From W Line Quarter
 1st. Report _____
 Completion SEP 19 1951
 Remarks Chance Pool

Spudding Date 7-29-51

Drlg. Data Oil well TD 4330

8" @ 852 Heeb. 3634 Br. lime 3790

KC 3815 Miss. 4266 DST 4266-86

open 1 hr. gas in 1 hr. Rec. 250' mud

640' ho & gcm 65' oil Kh. 4326

TD 4330 5" @ 4329 40/ 4300-10

B/ 64 go SSW 1 hr. 40/ 4280-90

S/ 1 bo 14 gw 1 hr. Hydrofrac

F/ 23 boph 5 hr. F/ 93 bo 7 hr.

P & F/ 100 bopd Comp. 185 bopd 2% water

J. E. TYRA