

Pratt

Section 32 Township 26 Range 13W

Well No. #3 Chance

Company Texas Co.

NORTH

						0	

WEST

EAST

SOUTH

Pratt

KANSAS

Sec. 32 Twp. 26 R. 13 W ✓

Well No. # 3 Chance Farm

Texas Co. Company

Contractor

Chance Pool


990 Ft. from N. Line

_____ Ft. from S. Line

990 Ft. from E. Line

_____ Ft. from W. Line

SW NE SE

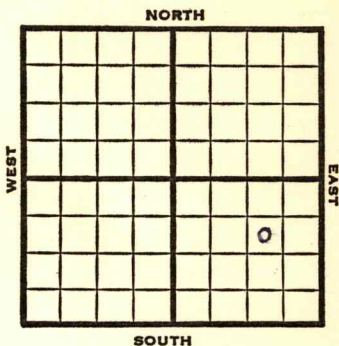

1951 **Elev. 1968'** REPORT

3/7 Spud 3-2-51
15" @ 843
Drilling 1425'

5/2 Spud 3-2-51
Oil Well TD 4435
15" @843 **Heeb. 3638**
Br Lime 3778'
Lans. 3806
DST 3989-3996 opn 1 hr
Rec. 30' mud **Viola 4298**
DST 4300-33 opn 48 min.
20 boph **Simp. 4350**
Sand 4359
DST 4359-70 opn 1 hr
Rec. 875' sw **Arb. 4432**
TD 4435 7" @ 4435
Perf/4310-18 B/1 1/3 boph
Perf/4306-10 no inc.
69/4318-24 F/180 bo 6 hr
F/154 bo 8 hr F/122 bo 14 hr
Comp. 130 bopd 50,000 gas

COMPLETED

