

Section 32 Township 26 Range 13W

Well No. #1 Tregallas

Company Continental Oil

NORTH

							0

WEST

EAST

SOUTH

Pratt
26

KANSAS

13W

Sec. 32 Twp.

R.

Well No. #1 Tregallas Farm

Continental Oil Company

Contractor

Chance Pool


330' Ft. from N. Line

Ft. from S. Line

330' Ft. from E. Line

Ft. from W. Line

NE NE NE

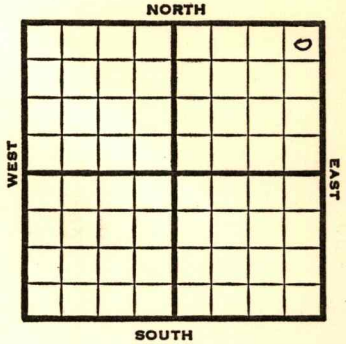

1951

Elev. 1953'

REPORT

5/16

Spud 5-12-51

13" @ 146

Anhy 839'

9" @ 859'

WOC

6/13

Spud 5-12-51

Oil Well TD 4284

13" @ 146

Anhy 839 9" @ 859

Lans. 3811 Miss 4259

DST 4260-68 opn 1 hr Rec. 60' mud

DST 4261-74 opn 1 hr. Rec. 45' mud

DST 4262-84 opn 1 hr. Rec. 60' gcm &

SO TD 4284 5" @ 4260 S/168 bopd

Comp. 120 bopd

COMPLETED

County Pratt State Kansas

Sec. 32 (^{Blk.}Twp.) 26 (^{Sur.}Rge.) 13W Map No.

Operator Continental Oil

Well No. 1 Farm Tregallas

Elev. 1953 Location NE NE NE

330 Ft. From N Line NE

330 Ft. From E Line Quarter

1st. Report

Completion JUN 13 1951

Remarks Chance Pool

COMPT. FTT

Spudding Date 5-12-51

Drig. Data Oil well TD 4284

13" @ 146 Anhy 839 9" @ 859

Lans. 3811 Miss. 4259 DST 4260-

68 open 1 hr. Rec. 60' mud

DST 4261-74 open 1 hr. Rec. 45'

mud DST 4262-84 open 1 hr.

Rec. 60' gem & SO TD 4284

5" @ 4260 S/. 168 bopd

Comp. 120 bopd

J. E. TYRA


County Pratt State Kansas

Sec. 32 (Blk. Twp.) 26 (Sur. Rge.) 13W Map No.

Operator Continental Oil

Well No. 1 Farm Tregallas

Elev. _____ Location NE NE NE

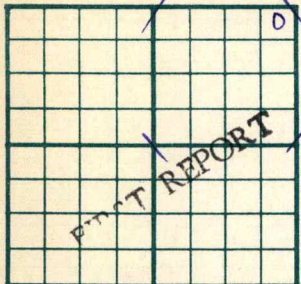

330 Ft. From N Line NE

330 Ft. From E Line Quarter

1st. Report MAY 16 1951

Completion _____

Remarks _____

Spudding Date 5-12-51

Drlg. Data Chance Pool

13" @ 146 Anhy 839 9" @ 859 WOC

J. E. TYRA