


Section 32 Township 26 Range 13W

Well No. 6 N. Tregellan (Tregallas)

Company Continental Oil

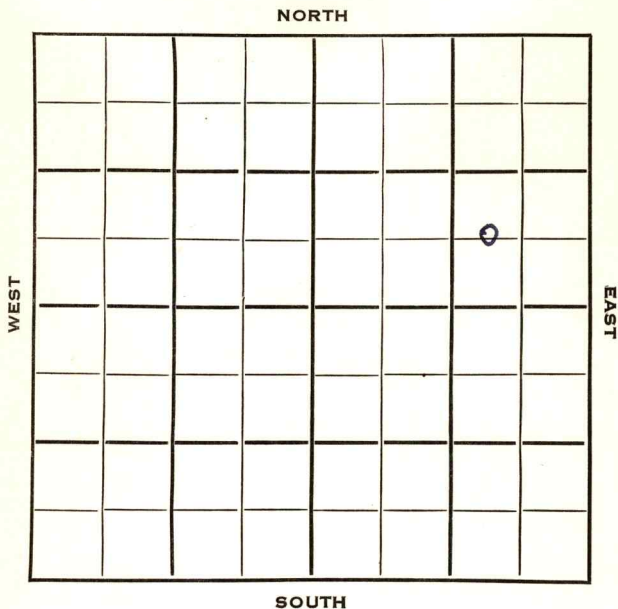

Pratt KANSAS

SEC.	TWP.	R.
32	26	13W ✓

WELL NO. 6 N. Tregellan FARM

COMPANY Continental Oil

CONTRACTOR Garvey


Chance Pool

_____ Ft. from N. Line

660 _____ Ft. from S. Line

990 _____ Ft. from E. Line

_____ Ft. from W. Line

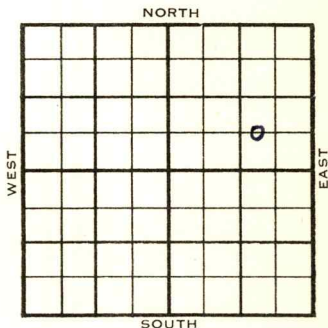

C W L S E N E

ELEVATION	REPORT
1954	1954'

4/7 Spud 4-4-54
 Anhy 841'
 9" @ 850
 WOC

6/15 Spud 4-4-54 Oil well TD 4304
 Anhy 841' 9" @ 850 Heeb 3644
 Br. lime 3788' Lans 3807' Miss 4291
 TD 4290' 5" @ 4279 DD 4304 sd-frac
 P/40 BO 9 hr. P/23 BO 2 BW 3 hr.
 P/83 BO 13 BW 17 hr. frac.
 Comp. 114 BOPD 5 BW

COMPLETED

