

KANSAS

Pratt


Section 33 Township 26 Range 13W

Well No. 2 Calbeck

Company Deep Rock et al

Moore

NORTH

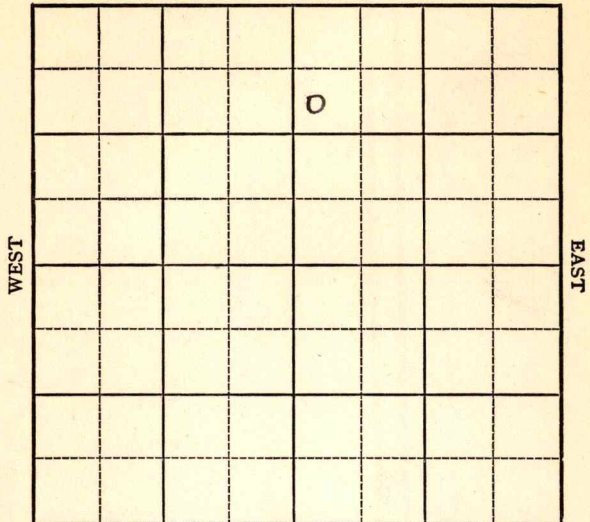

SOUTH

KANSAS

Pratt

Sec. 33 Twp. 26 R. 13W

Well No. #2 Colback Farm

Deep Rock et al Company

Moore Pool


990' Ft. from N. Line

Ft. from S. Line

Ft. from E. Line

330' Ft. from W. Line

SW NW NE

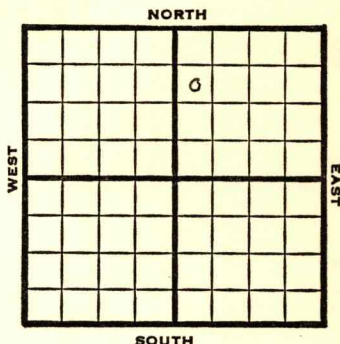

1949

Elev 1954'

REPORT

3/16

Location

3/23

Drlg 200'

3/30

8" @ 811'

Drlg. 2420'

4/6

Lansing 3776'

Drlg. 4207'

4/12

Viola 4247'

Simpson 4318'

Arbuckle 4412'

TD 4415'

4/20

TD 4418'

1500 acid

Swb 10 bbls oil PH

4/27

TD 4418'

Arb. 4412'

5" @ 4412'

1500 acid

Pump 50 Oil Pot

40⁹ Gr.

Comp

COMPLETED

Map No. _____ Sec. 33 Twp. 26 R. 13WWell No. 2 Calback

Deep Rock etal. _____ Company

FIRST REPORT _____ Contractor


SW NW NE

SECTION PLAT

990 Ft. from N. Line

_____ Ft. from S. Line

_____ Ft. from E. Line

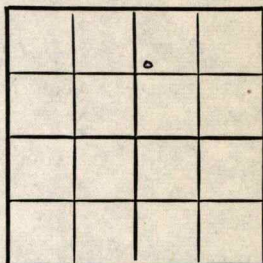330 Ft. from W. Line

Pratt County

Location X

Rig up _____

Drilling and Remarks:

RECORD

Cased _____ in., _____ ft.

Sand _____

Gas _____

Oil _____

Total Depth _____

PRODUCTION

1st 24 hrs. Nat. _____

1st 24 hrs. after shot _____

Gas _____ Cu. Ft.

Dry Hole _____

Abandoned _____

Date

MAR 16 1949 19

S. J. LEWIS

Scout

Kansas

Map No. K83 Sec. 33 Twp. 26 R. 13WWell No. 2 Calbeck

Deep Rock etal.

Company

COMPLETE

Contractor


SW NW NE

SECTION PLAT

990 Ft. from N. Line

Ft. from S. Line

Ft. from E. Line

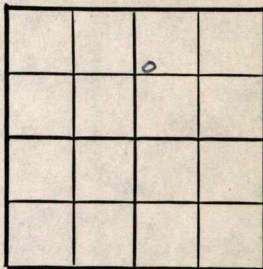330 Ft. from W. Line

Pratt County

Location

Rig up

Drilling and Remarks:


Cased _____ in., _____ ft.

Sand _____

Gas _____

Oil _____

Total Depth 4415**PRODUCTION**

1st 24 hrs. Nat. _____

1st 24 hrs. after shot _____

Gas _____ Cu. Ft.

Dry Hole _____

Abandoned _____

Date

APR 27 1949 19

S. J. LEWIS

Scout