


Section 32 Township 26 Range 13W

Well No. #4 Tregallas

Company Continental Oil

NORTH

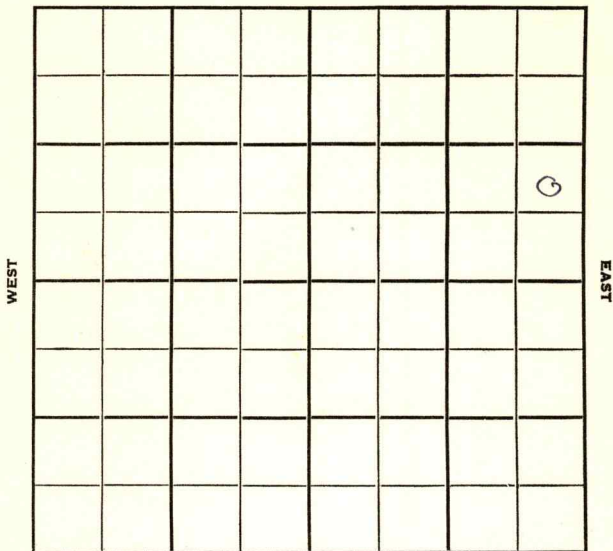

SOUTH

Pratt

KANSAS

Sec. 32 Twp. 26 R. 13W

Well No. #4 Tregallas Farm

Continental Oil Company

Contractor

Chance


Ft. from N. Line

990' Ft. from S. Line

330' Ft. from E. Line

Ft. from W. Line

NE SE NE

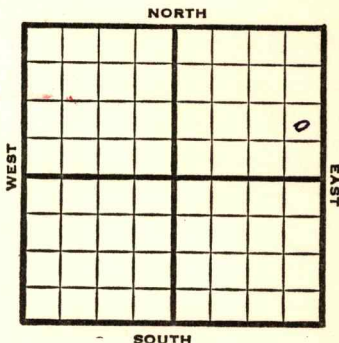

1952

Elev. 1954'

REPORT

2/27

Spud 2-24-52
Anhy 836
10" @ 855
WOC

3/5

Drlg. 3476'

3/12

Heeb. 3616 Tor 3632 Br Li 3772
Lans. 3791 Miss 4236 KH 4302
V 4330

DST 4285-4340 1 hr. 130' HO&GCM
1350#

DST 4330-40 1 hr. 8' M

RTD 4340 5" @ 4238 WOC

3/19

DP CO to 4340 S/ 1 boph for
6 hrs. to Hydra 4238-4340

4/2

Spud 2-24-52
Oil Well TD 4340'
Anhy 836 10" @ 855 Heeb. 3616
Tor. 3632 Br. Li 3772 Lans. 3791
Miss. 4236 Kh. 4302 Viola 4330
DST 4285-4340 open 1 hr. rec. 130'
HO&GCM
DST 4330-40 open 1 hr. rec. 8' mud
TD 5" @ 4238 CO to 4340 S/ 1 boph
6 hr. Hydro 4238-4340 S/ thru
tubing F/ 51 boph 1 hr. 31 bo
2nd hr. F/ 8 boph 7 hr. S&F
8 boph 20 hr. S/ 6 boph
Comp. 335 bopd

COMPLETED

County **Pratt** State **Kansas**

Sec. **32** (Blk. Twp.) **26** (Sur. Rge.) **13W** Map No.

Operator **Continental Oil**

Well No. **4** Farm **Tregallas**

Elev. Location **NE SE NE**

FIRST REPORT

990 Ft. From **S** Line **NE**

330 Ft. From **E** Line Quarter

1st. Report **FEB 27 1952**

Completion

Remarks

Spudding Date **2-24-52**

Drilg. Data **Chance**

Anhy 836 10" @ 855 W.O.C.

J. G. McGEHEE

