

Pratt

KANSAS

Section 33 Township 26 Range 13WWell No. #7 CalbeckCompany Deep Rock & Rine Drlg.

NORTH

							0

WEST

EAST

SOUTH

Pratt

KANSAS

Sec. 33 Twp. 26 R. 13W

Well No. #7 Calbeck Farm

Deep Rock & Rine Drlg. Company

Rine Drlg. - Contr. Contractor

Chance Pool


 Ft. from N. Line

990' Ft. from S. Line

330' Ft. from E. Line

 Ft. from W. Line

NE SE NE

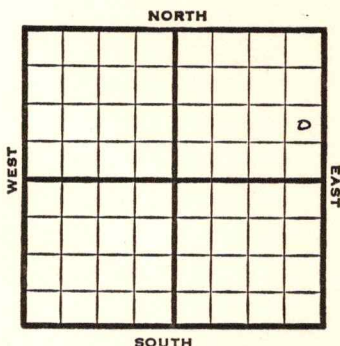


1950 **Elev 1954'** **REPORT**

12/6 Spud 11-28-50
10" @ 833'
Drlg. 2890'

1951
1/10 Spud 11-28-50
10" @ 833
DST 3831-51 opn 45 min rec 135' mud
& water
DST 3928-38 opn 45 min rec 390' hocm
KC 3780
DST 3967-88 opn 45 min rec 55' socm
Cong 4200 **Kinderhook 4222**
Viola 4254 **Simp 4295**
DST 4310-23 opn 1 hr rec 50' mud
DST 4322-46 opn 1 hr rec 275' free oil
275' mud & oil
Arb 4406-10
7" @ 4406
TD 4423
S/3 $\frac{1}{2}$ boph DD 4425 S/2 $\frac{1}{2}$ boph 500 A
S/8 boph
Comp 70 bopd
Completed TD 4425'

COMPLETED

County Pratt State Kansas
 Sec. 33 (Blk.) 26 (Sur.) 13W Map No.
 Operator Deep Rock & Rine Drlg.
 Well No. 7 Farm Calbeck
 Elev. 1954 Location NE SE NE

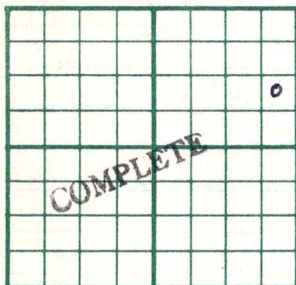

990 Ft. From S Line NE
330 Ft. From E Line Quarter

1st. Report

Completion JAN 10 1951

Remarks Chance Pool
Rine Drlg. - Contr.

Spudding Date 11-28-50

Drlg. Data Oil well TD 4425

10" @ 833 DST 3831-51 open 45 min.

Rec. 135' mud & water DST 3928-58

open 45 min. Rec. 390' hocom KC 3780

DST 3967-88 open 45 min. Rec. 55' socm

Cong. 4200 Kinderhook 4222 Viola 4254

Simp. 4295 DST 4310-23 open 1 hr.

Rec. 50' mud DST 4322-46 open 1 hr.

Rec. 275' free oil 275' mud & oil

Arb. 4406-10 7" @ 4406 TD 4423

S/ 3½ boph DD 4425 S/ 2½ boph 500 A

S/ 8 boph Comp. 70 bopd

J. E. TYRA