


KANSAS

Section 33 Township 26 Range 13-W

Well No. #8 Calbeck

Company Deep Rock & Rine Drlg.

NORTH

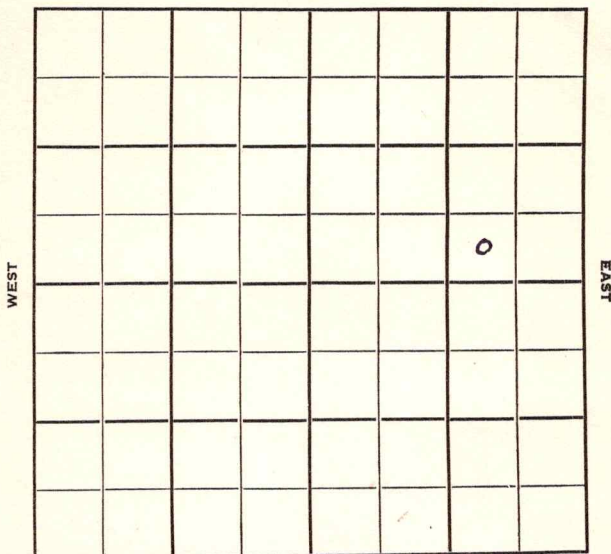

SOUTH

Pratt **KANSAS** ✓

Sec. 33 Twp. 26 R. 13W

Well No. #8 Calbeck Farm

Deep Rock & Rine Drlg. Company

Rine Drlg. - Contr. Contractor
Chance Pool


 Ft. from N. Line

330' Ft. from S. Line

990' Ft. from E. Line

 Ft. from W. Line

SW SE NE

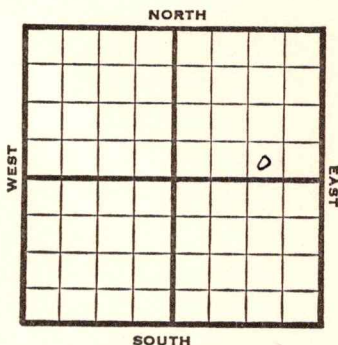

1950

Elev 1965' REPORT


12/27

Spud 12-21-50
8-5/8" 447'
Drlg. 2770'

1951

1/24

Spud 12-21-50
8 5/8" @ 447
Heeb 3606 **Br lime 3767**
Lans 3793
DST 3815-40 opn 45 min rec 90' ho&gcm
90' muddy oil 90' clean oil
cong 4199 **Kinderhook 4224**
Viola 4233
DST 4275-4310 opn 45 min rec 150' o&gcm
60' mud & oil
Simp 4327
DST 4323-45 opn 1 hr rec 75' so&gcm
DST 4345-75 opn 1 hr rec 270' sw
Arb 4428-30
5" @ 4430
TD 4432 F/18 gal free oil
DD 4434
500 A S/2½ bopd 1500 A S/5 boph
Comp 53 bopd
Completed TD 4432'
COMPLETED

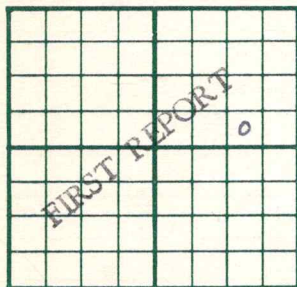County Pratt State KansasSec. 33 (Blk.) 26 (Sur.) 13W Map No.Operator Deep Rock & Rine Drlg.Well No. 8 Farm CalbeckElev. Location SW SE NE330 Ft. From S Line NE990 Ft. From E Line Quarter1st. Report DEC 27 1956


Completion

Remarks

Rine Drlg. - Contr.Spudding Date 12-21-50Drlg. Data Chance Pool3 5/8" @ 447 drlg. 2770

J. E. TYRA

County Pratt State Kansas
 Sec. 33 (Blk.
Twp.) 26 (Sur.
Rge.) 13W Map No.
 Operator Deep Rock & Rine Drlg.
 Well No. 8 Farm Calbeck
 Elev. 1965 Location SW SE NE

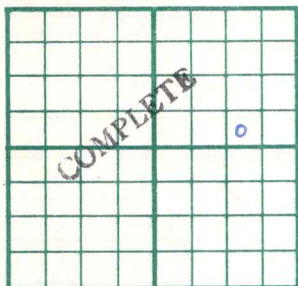

330 Ft. From S Line NE
990 Ft. From E Line Quarter

1st. Report

Completion JAN 24 1951

Remarks Chance Pool

Rine Drlg. - Contr.

Spudding Date 12-21-50

Drlg. Data Oil well TD 4432

8 5/8" @ 447 Heeb. 3606 Br. lime 3767

Lans. 3793 DST 3815-40 open 45 min.

Rec. 90' ho & gcm 90' muddy oil 90' clean

oil Cong. 4199 Kinderhook 4224 Viola

4233 DST 4275-4310 open 45 min.

Rec. 150' o & gcm 60' mud & oil

Simp. 4327 DST 4323-45 open 1 hr.

Rec. 75' so & gcm DST 4345-75 open 1 hr.

Rec. 270' sw Arb. 4428-30 5" @ 4430

TD 4432 B/ 18 gal free oil DD 4434

500 A S/ 2 1/2 bopd 1500 A S/ 5 boph

Comp. 53 bopd

J. E. TYRA