

Section 33 Township 26 Range 13-W

Well No. #6 Calbeck

Company Deep Rock & Pine Drlg.

NORTH

							0

WEST

EAST

SOUTH

Pratt

KANSAS

Sec. 33 Twp. 26 R. 13W

Well No. #6 Calbeck Farm

Deep Rock & Rine Drlg. Company

Rine Drlg. - Contr. Contractor

Iuka Pool


330' Ft. from N. Line

 Ft. from S. Line

330' Ft. from E. Line

 Ft. from W. Line

NE NE NE

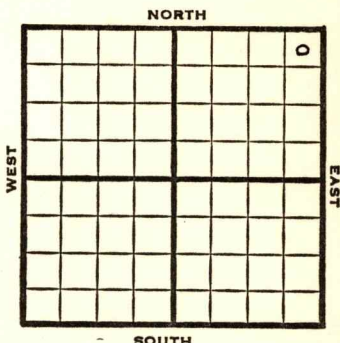

1950

Elev 1949'

REPORT

11/15

Spud 11-13-50
10" @ 525'

1951

1/10

Spud 11-13-50
10" @ 525'

Lans 3769

DST 3790-3811 opn 45 min rec 150' o&gcm
90' oil

DST 4253-90 opn 1/2 hr rec 360' o&gcm
810' free oil

DST 4294-4341 opn 1 hr rec 180' o&gcm
720' oil

Viola 4251

Simp 4297

Arb 4399-4404

7" @ 4401

TD 4426

Free oil 4424-26

S/60 bo S/16 boph


P/3 boph

Comp 70 bopd

Completed

COMPLETED

County Pratt State Kansas
 Sec. 33 (Blk. Twp.) 26 (Sur. Rge.) 13W Map No.
 Operator Deep Rock & Rine Drlg.
 Well No. 6 Farm Calbeck
 Elev. 1949 Location NE NE NE

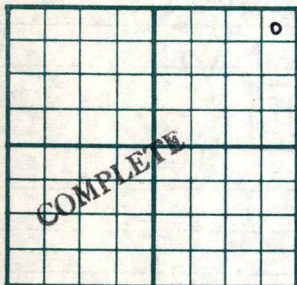

330 Ft. From N Line NE
330 Ft. From E Line Quarter

1st. Report

Completion JAN 1 0 1951

Remarks Iuka Pool

Rine Drlg. - Contr.

Spudding Date 11-13-50

Drlg. Data Oil well TD 4426

10" @ 525 Lans. 3769 DST 3790-3811

open 45 min. Rec. 150' o&gcm 90' oil

DST 4253-90 open $\frac{1}{2}$ hr. Rec. 360' o & gcm

810' free oil DST 4294-4341 open 1 hr.

Rec. 180' o & gcm 720' oil Viola 4251

Simp. 4297 Arb. 4399-4404 7" @ 4401

TD 4426 Free oil 4424-26 S/ 60 bo

S/ 16 boph P/ 3 boph

Comp. 70 bopd

J. E. TYRA