


Pratt

KANSAS

Section 33 Township 26 Range 13W

Well No. #3 Lemon

Company Deep Rock

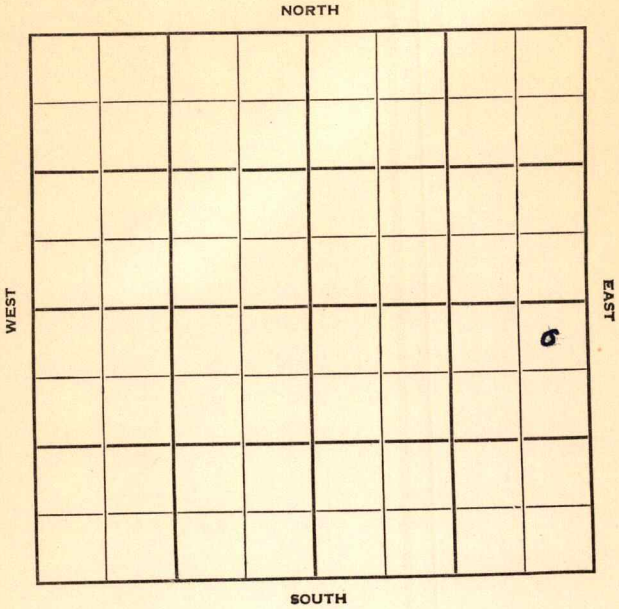

Pratt

KANSAS

Sec. 33 Twp. 26 R. 13 W

Well No. # 3 Lemon Farm _____

Deep Rock Company _____

Rine Contractor _____


330 Ft. from N. Line

_____ Ft. from S. Line

330 Ft. from E. Line

_____ Ft. from W. Line

NE NE SE

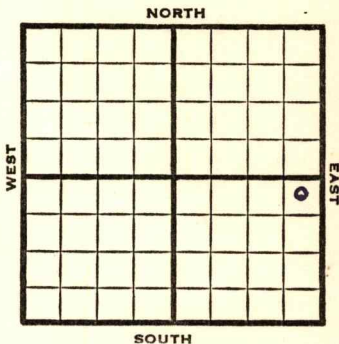

1952

Elev. 1956' REPORT

- 8/6 Location
- 8/13 "
- 8/20 "
- 8/27 8" @
- 9/3 8" @ 860
Drlg. 3700'
- 9/10 DST 4180-4204 1 hr. 30' SGCM
1125# DST 4208-25 1 hr. 270'
gas 25' M 375# Drlg. 4255'
- 9/17 DST 4225-55, 1 hr. 37' SGCM 1150#
DST 4275-4320 in V. 1 hr. 3450'
gassy oil 1200# **Simp. 4328**
DST 4329-47, 1 hr. 1800' gas 50'
HO&GCM, 1/2 gal. free oil 360#
DST 4346-60, 1 hr. 15'm 0#
DST 4359-78, 1 hr. 40'm 240#
Arb. 4433 RTD 4470'
5" @ 4469'
- 9/24 **Heeb. 3612 Br Li 3773 Lans. 3798**
Miss 4192 KH 4220 V 4276
42/4333-40 500 A S/5 galoph sd-frac
500 A PB 4316 72/4280-92
S/2½ boph pr 14 hrs. 500 A
S/11 BOPH
- 10/1 POP

OVER

1952
10/8

Spud 8-25-52'
Oil well TD 4470' 8" @ 860
DST 4180-4204 open 1 hr, rec 30' SGCM
1125#
DST 4208-25 open 1 hr, rec 270' gas
25' mud 375#
DST 4225-55 open 1 hr, rec 37' SGCM
1150#
DST 4275-4320 open 1 hr. rec 3450'
gassy oil 1200# **Simp. 4328'**
DST 4329-47 open 1 hr, rec 1800' gas
50' HO & GCM, $\frac{1}{2}$ gal free oil 360#
DST 4346-60 open 1 hr. rec 15' mud
0#
DST 4359-78 open 1 hr, rec 40' mud
240#
Arb. 4433' TD 4470' 5" @ 4469'
Heeb 3612' **Br. lime 3773'** **Lans 3798**
Miss 4192' **Kh. 4220'** **Viola 4276'**
42/4333-40 500 A S/5 GOPH sd-frac.
500 A PB 4316' 72/4280-92 S/2 $\frac{1}{2}$
BOPH 500 A S/11 BOPH
Comp. 188 BOPD 1% wtr.

COMPLETED

County Pratt State Kansas
 Sec. 33 (Blk. 26) (Sur. 13W) (Twp.) (Rge.) Map No.
 Operator Deep Rock
 Well No. 3 Farm Lemon
 Elev. 1956 Location NE NE SE

330 Ft. From N Line SE330 Ft. From E Line Quarter

1st. Report

Completion OCT 8 1952

Remarks

Rine Drlg. - Contr.Spudding Date 8-25-52Drlg. Data Oil well TD 44708" @ 860 DST 4180-4204 open 1 hr.Rec. 30' sgcm 1125# DST 4208-25open 1 hr. Rec. 270' gas 25' mud 375#DST 4225-55 open 1 hr. Rec. 37' sgcm1150# DST 4275-4320 open 1 hr.Rec. 3450' gassy oil 1200# Simp. 4328DST 4329-47 open 1 hr. Rec. 1800' gas50' ho & gcm $\frac{1}{2}$ gal. free oil 360#DST 4346-60 open 1 hr. Rec. 15' mud0# DST 4359-78 open 1 hr. Rec. 40' mud240# Arb. 4433 TD 4470 5" @ 4469Heeb. 3612 Br. lime 3773 Lans. 3798Miss. 4192 Kh. 4220 Viola 427642/ 4333-40 500 A S/ 5 goph sd-frac

J. G. McGEHEE

Drig. Data

500 A PB 4316 72/ 4280-92 S/ 2 $\frac{1}{2}$ boph

500 A S/ 11 boph

Comp. 188 bopd

1% wtr.

Scott Cards
Land Small Map
Land Wall Map
Tracings
France Map
France Map
Misc

5

llllll

OCT 16 1952