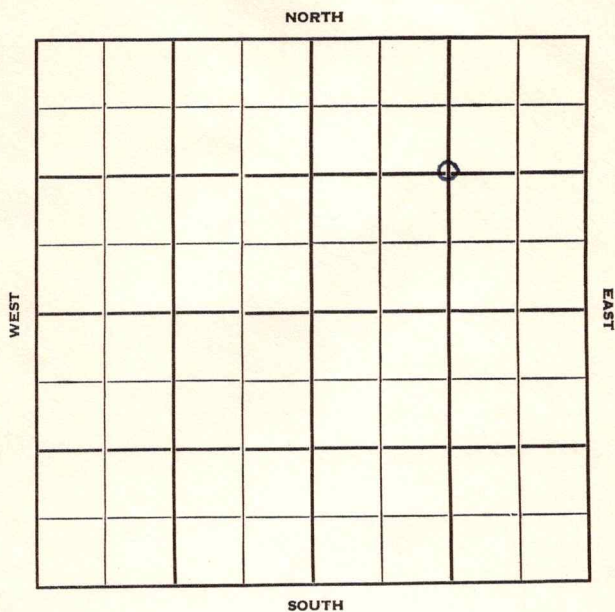


Section 33 Township 26 Range 13 WWell No. # 9 CalbeckCompany Deep Rock Oil

Pratt KANSAS

Sec. 33 Twp. 26 R. 13 W ✓

Well No. # 9 Calbeck Farm

Deep Rock Oil Company

Contractor

Chance Pool


1320 Ft. from N. Line

Ft. from S. Line

1320 Ft. from E. Line

Ft. from W. Line

C NE/4

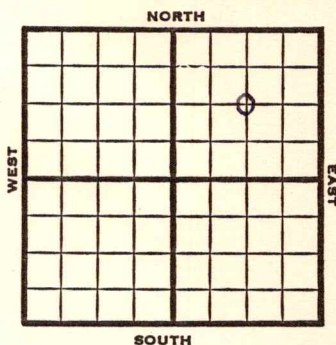

1951 Elev. 1951' REPORT

3/21 Location

7/3 Spud 4-9 51

SWD Well

TD 5170

10" @ 696 DST 4424-38 opn ½ hr

Rec. 120' oil 60' mud & oil

DST 4439-55 opn 1 hr Rec. 1365'

mud & oil 540' clean oil

Arb. 4402

DST 4488-4503 opn ½ hr Rec. 705'

sul wtr Heeb. 3581

Tor. 3600 Br Lime 3746

TD 5170 7" @ 4485 KC 3770

Miss 4180 Kh 4240 Viola 4254

Simp 4300 Lime 5106

Granite 5158 TD 5170 1000 A

Comp. for SWD well

COMPLETED

County **Pratt** State **Kansas**Sec. **33** (Blk. Twp.) **26** (Sur. Rge.) **13W** Map No.Operator **Deep Rock Oil**Well No. **9** Farm **Calbeck** **SWD**Elev. Location **C NE/4****1320** Ft. From **N** Line **NE****1320** Ft. From **E** Line Quarter1st. Report **MAR 21 1951**

Completion

Remarks

Spudding Date

Drlg. Data **Chance Pool****Location**

J. E. TYRA

County Pratt State Kansas
 Sec. 33 (Blk.) 26 (Sur.) 13W Map No.
 Operator Deep Rock Oil
 Well No. 9 Farm Calbeck SWD
 Elev. 1951 Location C NE/4



1320 Ft. From N Line NE
1320 Ft. From E Line Quarter
 Ist. Report
 Completion JUL 3 1951
 Remarks Chance Pool

Spudding Date 4-9-51

Drig. Data SWD well TD 5170

10" @ 696 DST 4424-38 open $\frac{1}{2}$ hr.

Rec. 120' oil 60' mud & oil DST 4439-55

open 1 hr. Rec. 1365' mud & oil 540'

clean oil Arb. 4402 DST 4488-4503

open $\frac{1}{2}$ hr. Rec. 705' sulph. water

Heeb. 3581 Tor. 3600 Br. lime 3746

TD 5170 7" @ 4485 KC 3770 Miss. 4180

Kh. 4240 Viola 4254 Simp. 4300

Lime 5106 Granite 5158 TD 5170 1000 A

Comp. for SWD well

J. E. TYRA